

SANDIA REPORT

SFP 30 1996

SAND96-1326/2 • UC-721

Unlimited Release

Printed August 1996

Waste Isolation Pilot Plant Shaft Sealing System Compliance Submittal Design Report

Volume 2 of 2: Appendix E

RECEIVED

OCT 15 1996

OSI

Repository Isolation Systems Department

Prepared by
Sandia National Laboratories
Albuquerque, New Mexico 87185 and Livermore, California 94550
for the United States Department of Energy
under Contract DE-AC04-94AL85000

Approved for public release; distribution is unlimited.

DISCLAIMER

This report was prepared as an account of work sponsored by an agency of the United States Government. Neither the United States Government nor any agency thereof, nor any of their employees, makes any warranty, express or implied, or assumes any legal liability or responsibility for the accuracy, completeness, or usefulness of any information, apparatus, product, or process disclosed, or represents that its use would not infringe privately owned rights. Reference herein to any specific commercial product, process, or service by trade name, trademark, manufacturer, or otherwise does not necessarily constitute or imply its endorsement, recommendation, or favoring by the United States Government or any agency thereof. The views and opinions of authors expressed herein do not necessarily state or reflect those of the United States Government or any agency thereof.

MASTER

MASTER

SF2900Q(8-81)

DISTRIBUTION OF THIS DOCUMENT IS UNLIMITED

DISCLAIMER

**Portions of this document may be illegible
in electronic image products. Images are
produced from the best available original
document.**


STE ISOLATION PILOT PLANT

CARLSBAD, NM


AFT SEALING SYSTEM DESIGN

DESIGN DRAWINGS

DRAWING NUMBER	TITLE	DRAWING NUMBER	TITLE
SNL-007 10 OF 28	WIPP SHAFT SEALING SYSTEM SALADO FORMATION AIR INTAKE SHAFT STRATIGRAPHY & SEALING SUBSYSTEM PROFILE	SNL-007 19 OF 28	WIPP SHAFT SEALING SYSTEM NEAR-SURFACE/RUSTLER FORMATIONS SALT HANDLING SHAFT STRATIGRAPHY & SEALING SUBSYSTEM PROFILE
SNL-007 11 OF 28	WIPP SHAFT SEALING SYSTEM AIR INTAKE SHAFT SHAFT STATION MONOLITH	SNL-007 20 OF 28	WIPP SHAFT SEALING SYSTEM SALADO FORMATION SALT HANDLING SHAFT STRATIGRAPHY & SEALING SUBSYSTEM PROFILE
SNL-007 12 OF 28	WIPP SHAFT SEALING SYSTEM NEAR-SURFACE/RUSTLER FORMATIONS EXHAUST SHAFT STRATIGRAPHY & AS-BUILT ELEMENTS	SNL-007 21 OF 28	WIPP SHAFT SEALING SYSTEM SALT HANDLING SHAFT SHAFT STATION MONOLITH
SNL-007 13 OF 28	WIPP SHAFT SEALING SYSTEM SALADO FORMATION EXHAUST SHAFT STRATIGRAPHY & AS-BUILT ELEMENTS	SNL-007 22 OF 28	WIPP SHAFT SEALING SYSTEM CONCRETE-ASPHALT WATERSTOP IN SALADO FORMATION
SNL-007 14 OF 28	WIPP SHAFT SEALING SYSTEM NEAR-SURFACE/RUSTLER FORMATIONS EXHAUST SHAFT STRATIGRAPHY & SEALING SUBSYSTEM PROFILE	SNL-007 23 OF 28	WIPP SHAFT SEALING SYSTEM ASPHALT COLUMN
SNL-007 15 OF 28	WIPP SHAFT SEALING SYSTEM SALADO FORMATION EXHAUST SHAFT STRATIGRAPHY & SEALING SUBSYSTEM PROFILE	SNL-007 24 OF 28	WIPP SHAFT SEALING SYSTEM UPPER AND LOWER SALADO COMPACTED CLAY COLUMNS
SNL-007 16 OF 28	WIPP SHAFT SEALING SYSTEM EXHAUST SHAFT SHAFT STATION MONOLITH	SNL-007 25 OF 28	WIPP SHAFT SEALING SYSTEM COMPACTED SALT COLUMN
SNL-007 17 OF 28	WIPP SHAFT SEALING SYSTEM NEAR-SURFACE/RUSTLER FORMATIONS SALT HANDLING SHAFT STRATIGRAPHY & AS-BUILT ELEMENTS	SNL-007 26 OF 28	WIPP SHAFT SEALING SYSTEM CONCRETE PLUG
SNL-007 18 OF 28	WIPP SHAFT SEALING SYSTEM SALADO FORMATION SALT HANDLING SHAFT STRATIGRAPHY & AS-BUILT ELEMENTS	SNL-007 27 OF 28	WIPP SHAFT SEALING SYSTEM RUSTLER COMPACTED CLAY COLUMN
		SNL-007 28 OF 28	WIPP SHAFT SEALING SYSTEM COMPACTED EARTHEN FILL AND CONCRETE PLUG

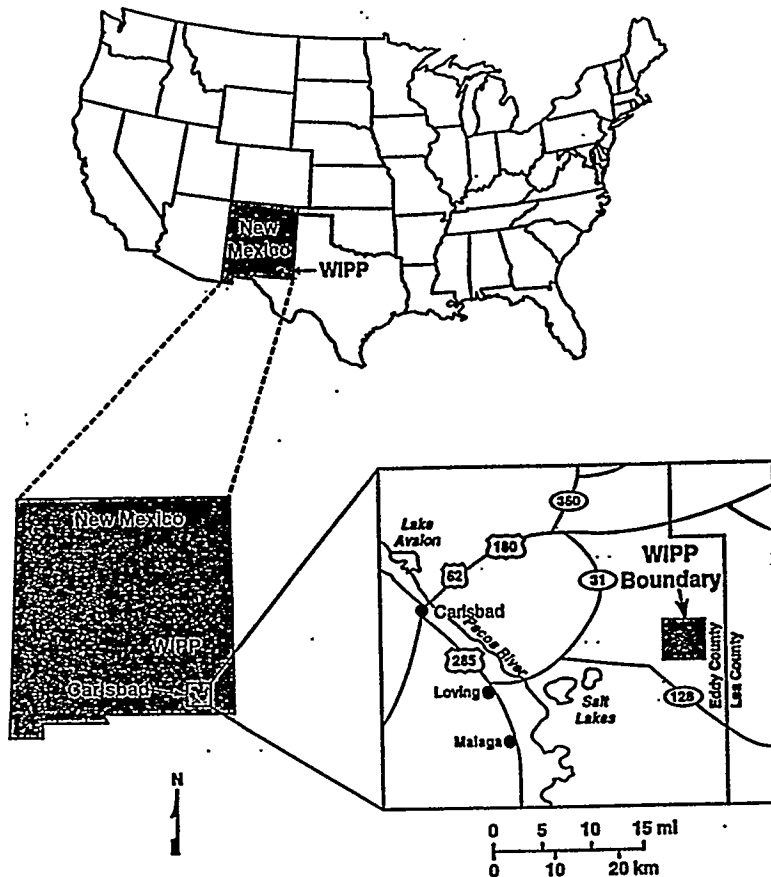

WIPP LAYOUT

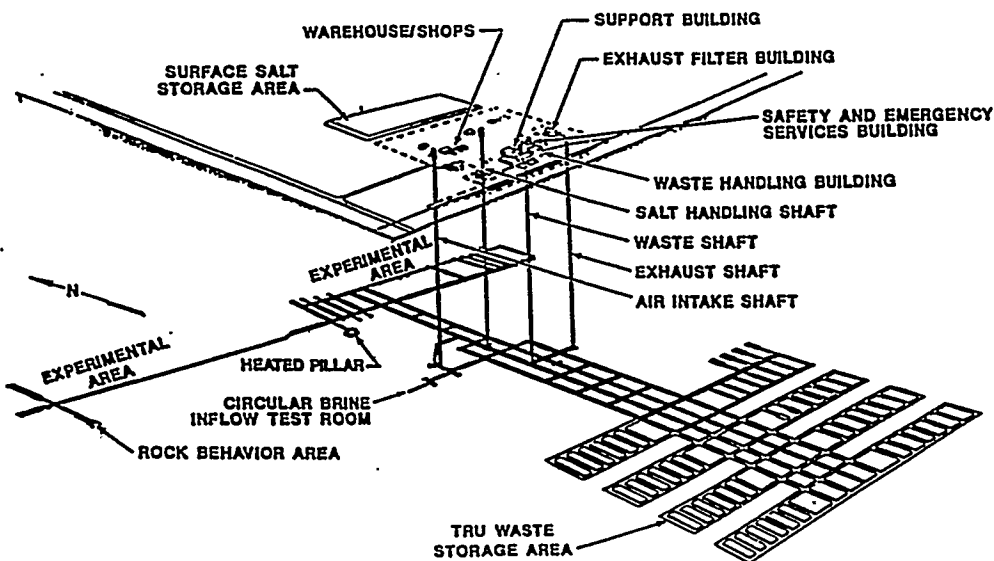

DRAWING NUMBER	TITLE
SNL-007 1 OF 28	WIPP SHAFT SEALING SYS SHAFT LOCATION PLAN, ABBREVIATIONS, GENERAL NOTES AND LEGEND
SNL-007 2 OF 28	WIPP SHAFT SEALING SYS NEAR-SURFACE/RUSTLER FC WASTE SHAFT STRATIGRAPHY & AS-BUILT ELEMENTS
SNL-007 3 OF 28	WIPP SHAFT SEALING SYS SALADO FORMATION WASTE SHAFT STRATIGRAPHY & AS-BUILT ELEMENTS
SNL-007 4 OF 28	WIPP SHAFT SEALING SYS NEAR-SURFACE/RUSTLER FC WASTE SHAFT STRATIGRAPHY & SEALING SUBSYSTEM PROFILE
SNL-007 5 OF 28	WIPP SHAFT SEALING SYS SALADO FORMATION WASTE SHAFT STRATIGRAPHY & SEALING SUBSYSTEM PROFILE
SNL-007 6 OF 28	WIPP SHAFT SEALING SYS WASTE SHAFT SHAFT STATION MONOLITH
SNL-007 7 OF 28	WIPP SHAFT SEALING SYS NEAR-SURFACE/RUSTLER F AIR INTAKE SHAFT STRATIGRAPHY & AS-BUILT ELEMENTS
SNL-007 8 OF 28	WIPP SHAFT SEALING SYS SALADO FORMATION AIR INTAKE SHAFT STRATIGRAPHY & AS-BUILT ELEMENTS
SNL-007 9 OF 28	WIPP SHAFT SEALING SYS NEAR-SURFACE/RUSTLER F AIR INTAKE SHAFT STRATIGRAPHY & SEALING SUBSYSTEM PROFILE





GENERAL NOTES:

1. THE DRIFT NUMBERING SYSTEM (E-300, S-400, ETC.) IS BASED ON THE DIRECTION AND NOMINAL DISTANCE IN FEET THE DRIFT IS FROM THE SALT HANDLING SHAFT'S DESIGNATED CENTERLINE LOCATION OF N-000, E-000. THE WIPP PLANT COORDINATE SYSTEM CENTERLINE LOCATION FOR THE SALT HANDLING SHAFT IS N9687.23, AND E6894.89. THE PLANT COORDINATE SYSTEM IS DESCRIBED IN WESTINGHOUSE DRAWING NO. 51-W-109-W, UNDERGROUND EXCAVATIONS, DATED 6/15/92.
2. THE AS-BUILT DIMENSIONS AND DEPTHS AND/OR ELEVATIONS SHOWN IN THESE DRAWINGS ARE NOMINAL IN THAT DIMENSIONS MAY CHANGE DUE TO LOCAL VARIANCE OF THE STRATIFICATION, OPERATIONAL MODIFICATIONS MADE TO SUIT THE CREEP CLOSURE OF THE HALITE, AND OTHER OPERATIONAL REQUIREMENTS. THEREFORE THE AS-BUILT DIMENSIONS AND THE PERTINENT ELEVATIONS FOR SITING THE SEALING SYSTEM SHALL BE VERIFIED BY FIELD SURVEYING AND EXPLORATORY CORE DRILLING DURING SITE PREPARATION FOR THE FINAL CONSTRUCTION.

3. DRAWING NUMBERS:

FOR CLARITY ON DETAIL AND SECTION DESIGNATIONS, AND NOTES, ONLY THE SHEET NUMBER IS SHOWN.

LEGEND FOR PROPOSED SHAFT SEALING SYSTEM:

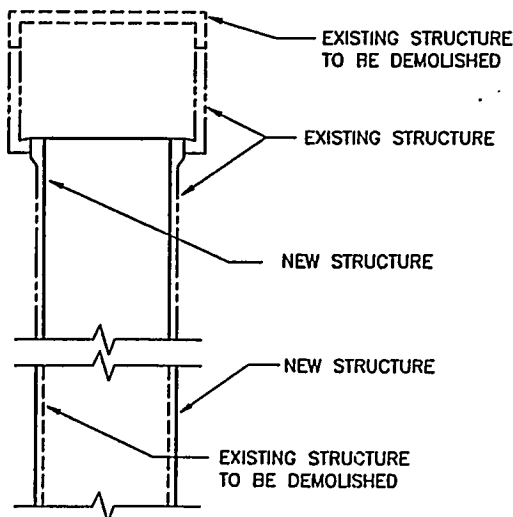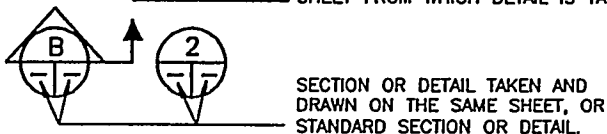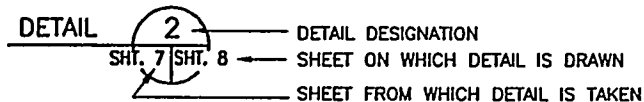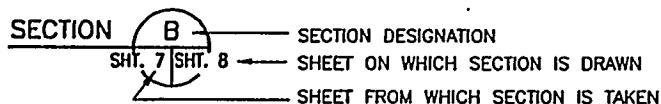

ABBREVIATIONS:


CL	CENTERLINE
ANH.	ANHYDRITE
CMP	CORRUGATED METAL PLATE
CONC.	CONCRETE
DOE	DEPARTMENT OF ENERGY
DWG.	DRAWING
E	EAST
EL.	ELEVATION
EXIST.	EXISTING
FT.	FOOT, FEET
HT.	HEIGHT
I.D.	INSIDE DIAMETER
IN.	INCHES
MB	MARKER BED
MIN.	MINIMUM
MSL	MEAN SEA LEVEL
N	NORTH
NO.	NUMBER
R	RADIUS
S	SOUTH
SHT.	SHEET NUMBER
SMC	SALADO MASS CONCRETE
TYP.	TYPICAL
USGS	UNITED STATES GEOLOGICAL SURVEY
W	WEST
WID	WESTINGHOUSE WASTE ISOLATION DIVISION
WIPP	WASTE ISOLATION PILOT PLANT



Albert W. Dennis
8-2-96

0	8/2/96	ISSUED FOR RECORDS PACKAGE	BY	CK.	APP.
REV.	DATE	DESCRIPTION	BY	CK.	APP.
SANDIA NATIONAL LABORATORIES WIPP A/E SUPPORT WIPP SHAFT SEALING SYSTEM SHAFT LOCATION PLAN, ABBREVIATIONS, GENERAL NOTES AND LEGEND					
CONTRACT NO: AG-4909 NAME BY <i>SAE</i> 8/2/96 CK. <i>SAE</i> 8/2/96 APP. <i>SAE</i> 8/2/96 APP. <i>SAE</i> 8/2/96			SCALE: SIZE B SNL DWG. NO. SNL-007 SHEET NO. 1 OF 28		


E-4

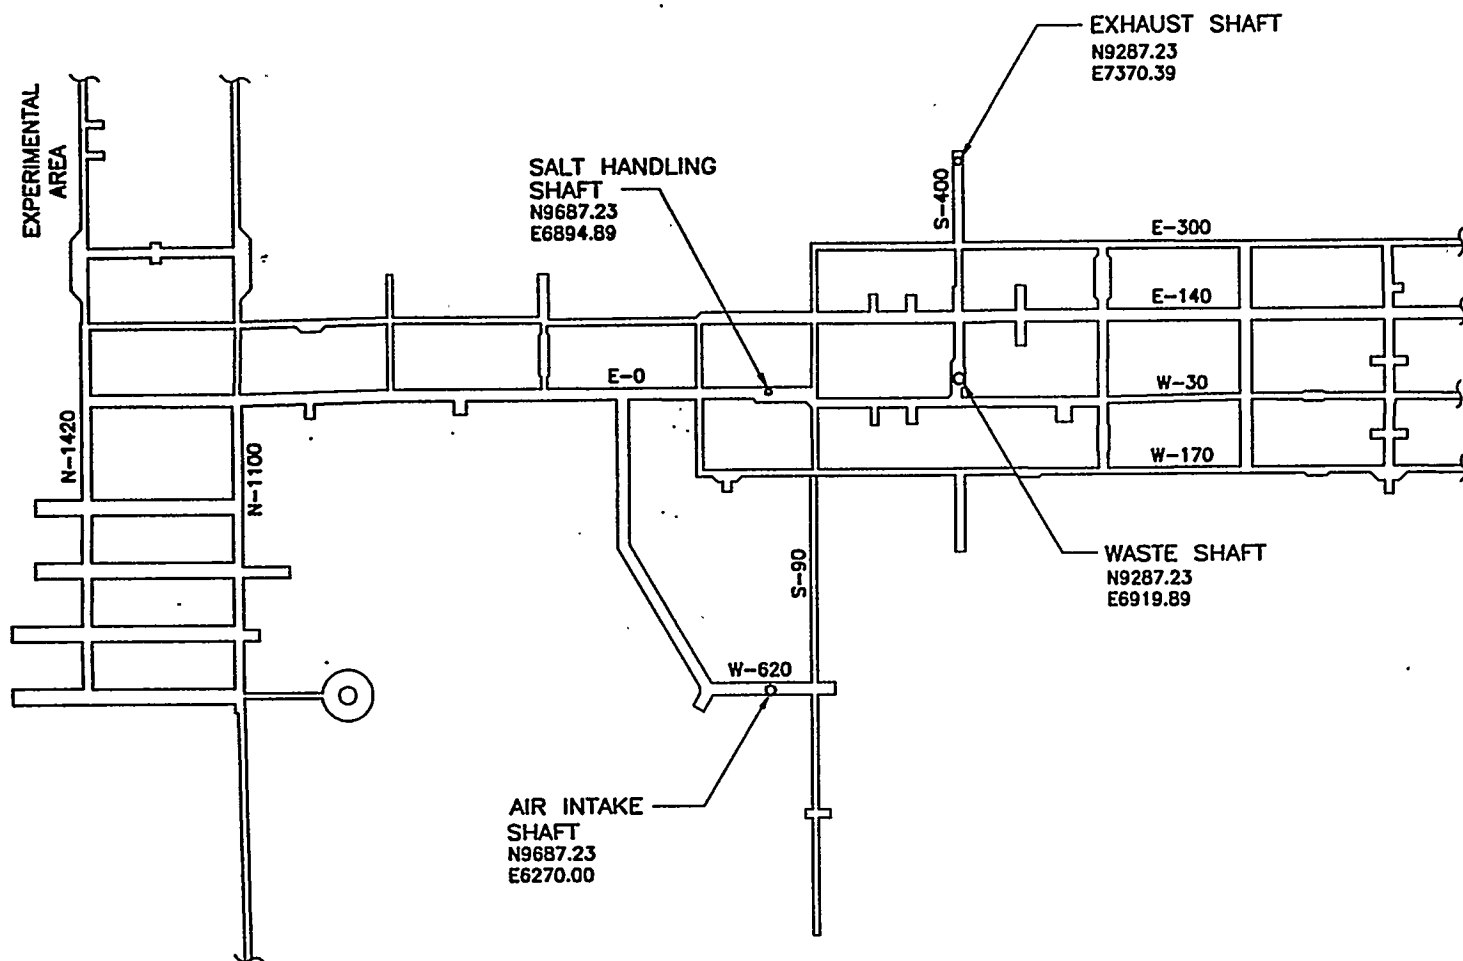


SHAFT SEALS LOCATION PLAN







SCALE IN FEET

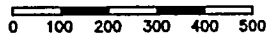

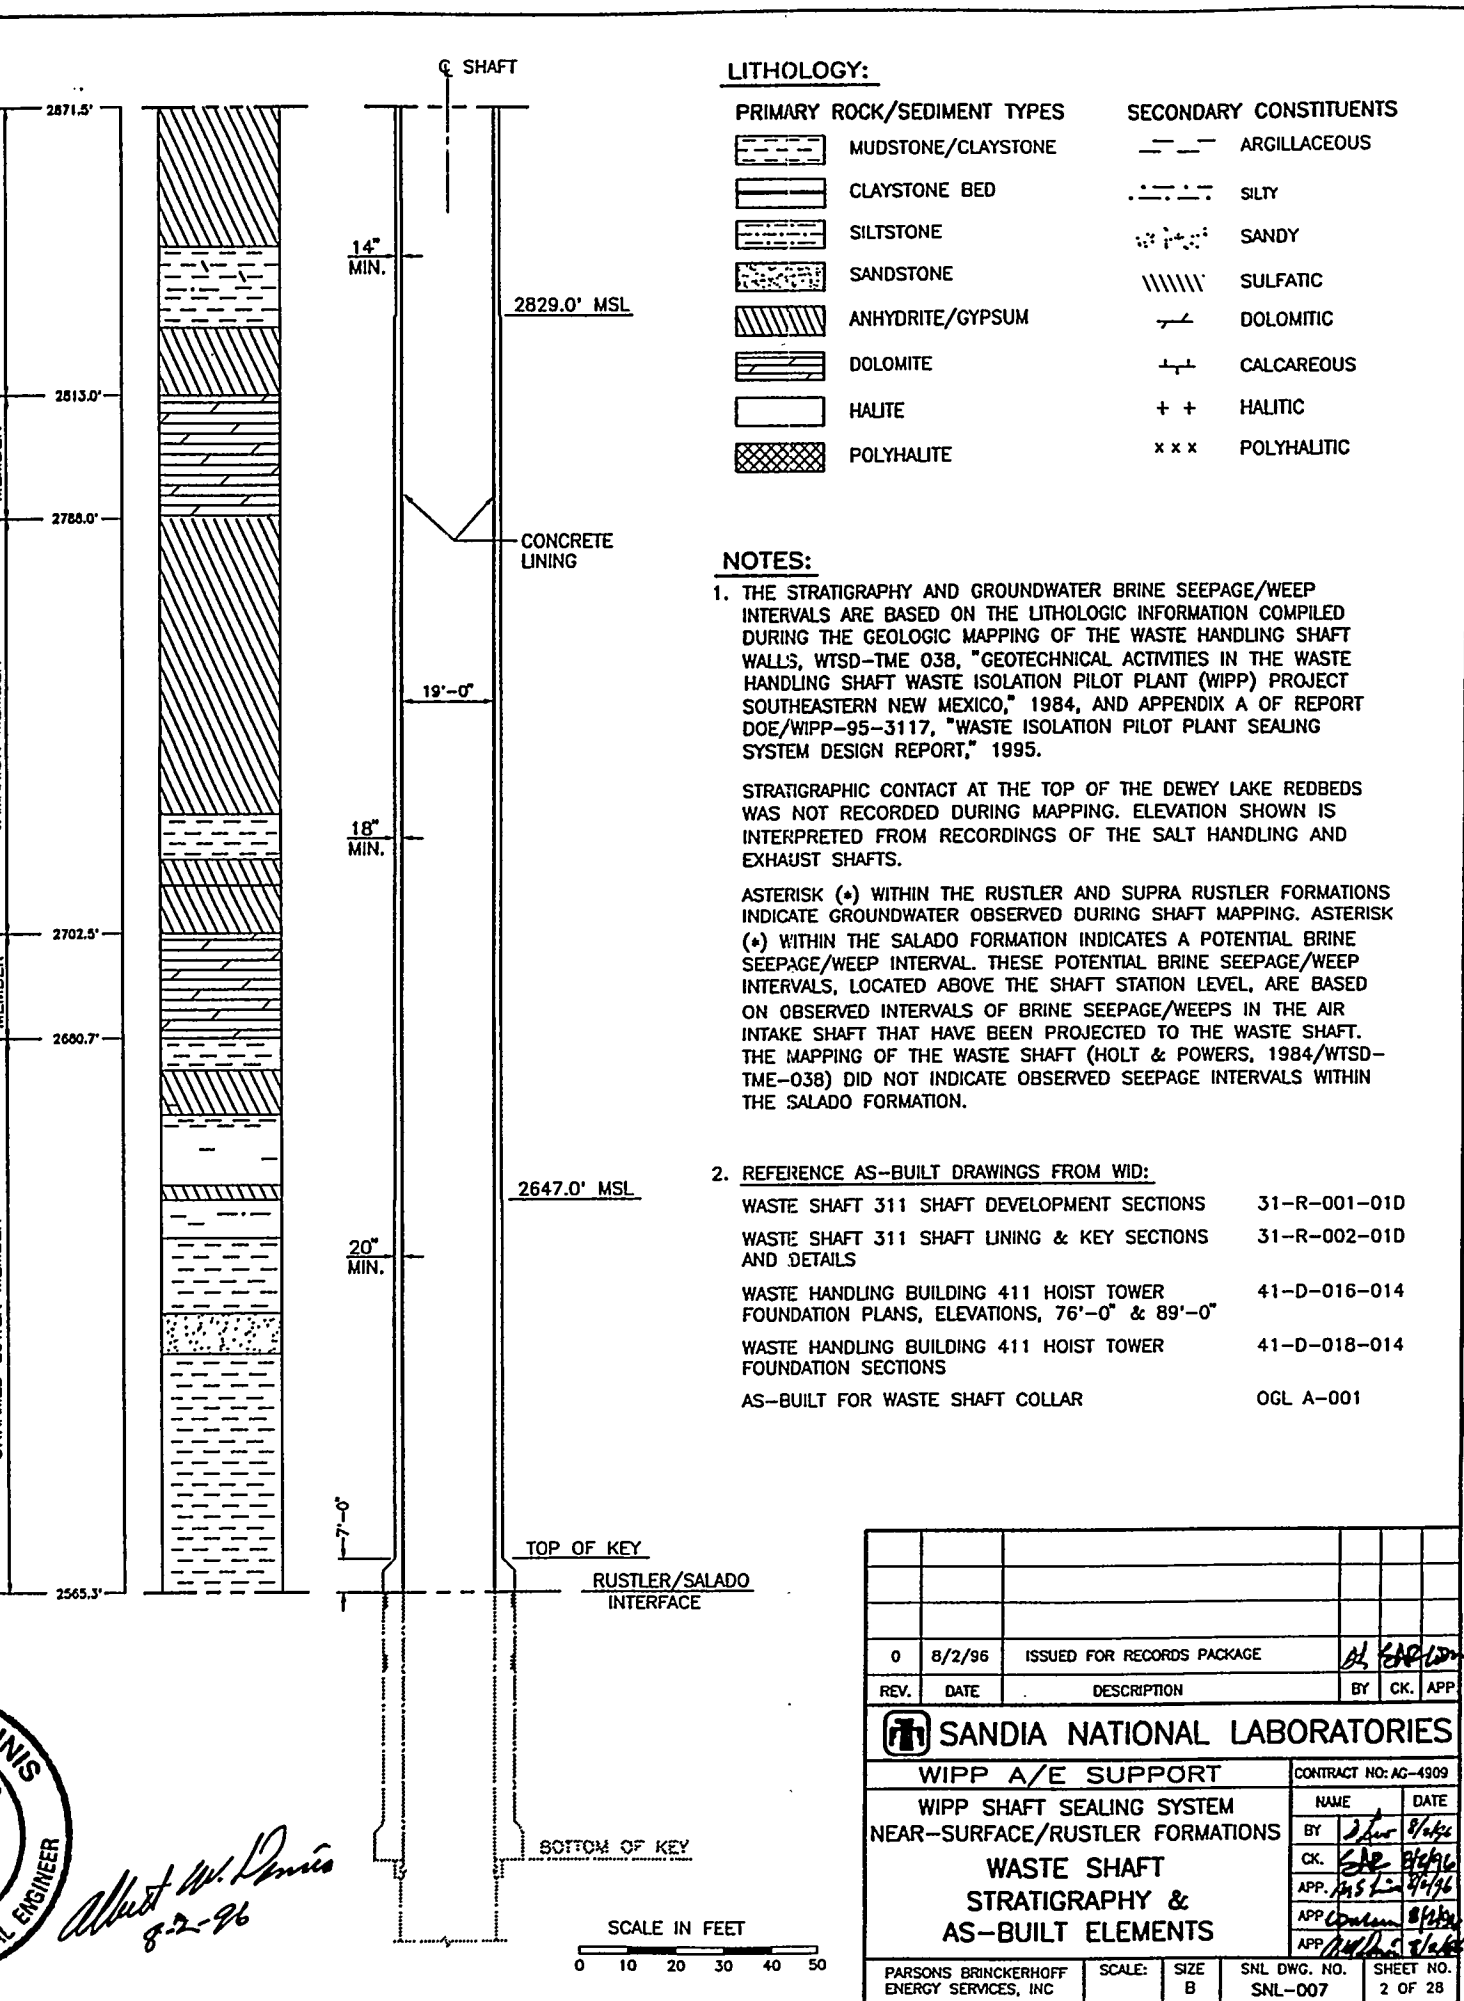


STRATIGRAPHY
(SEE NOTE 1)

SHAFT

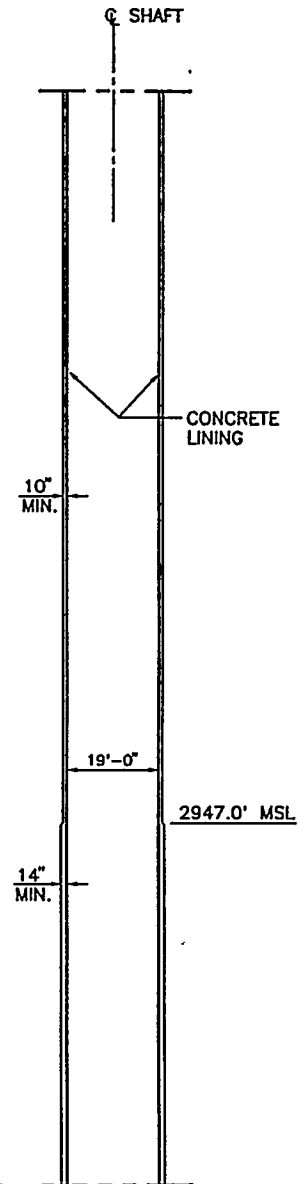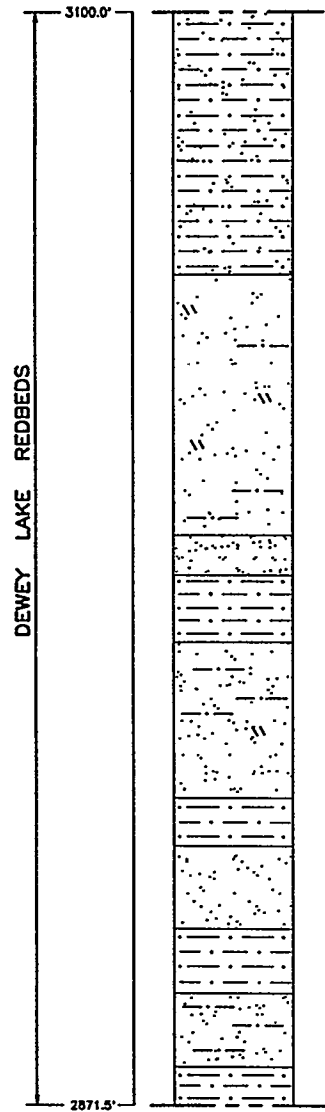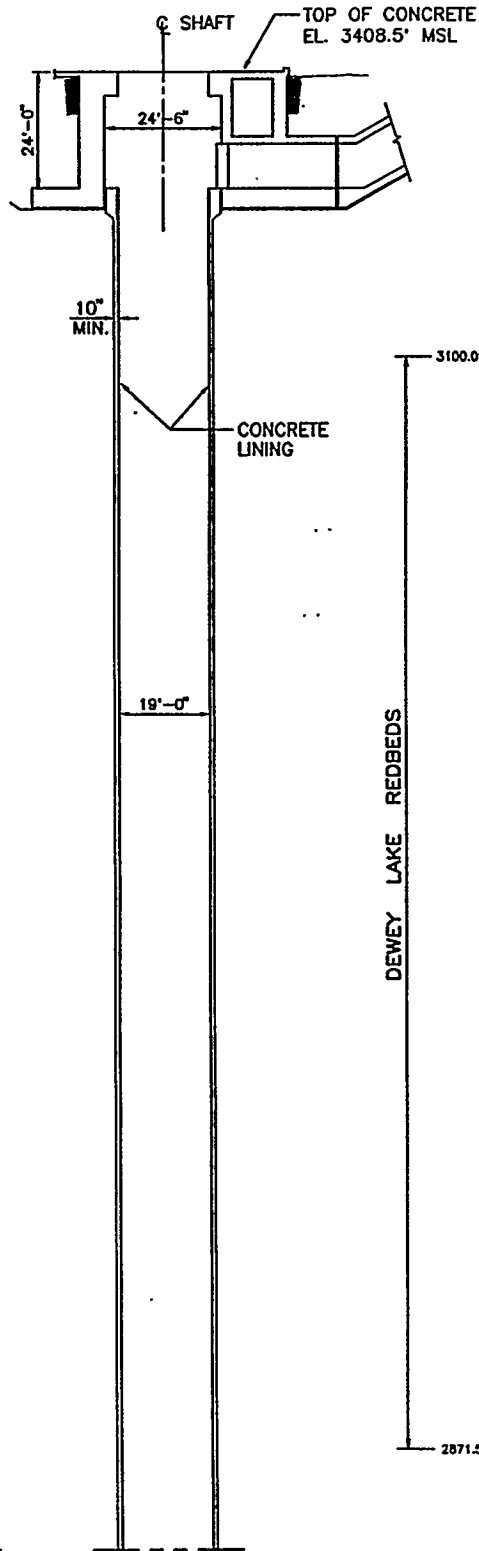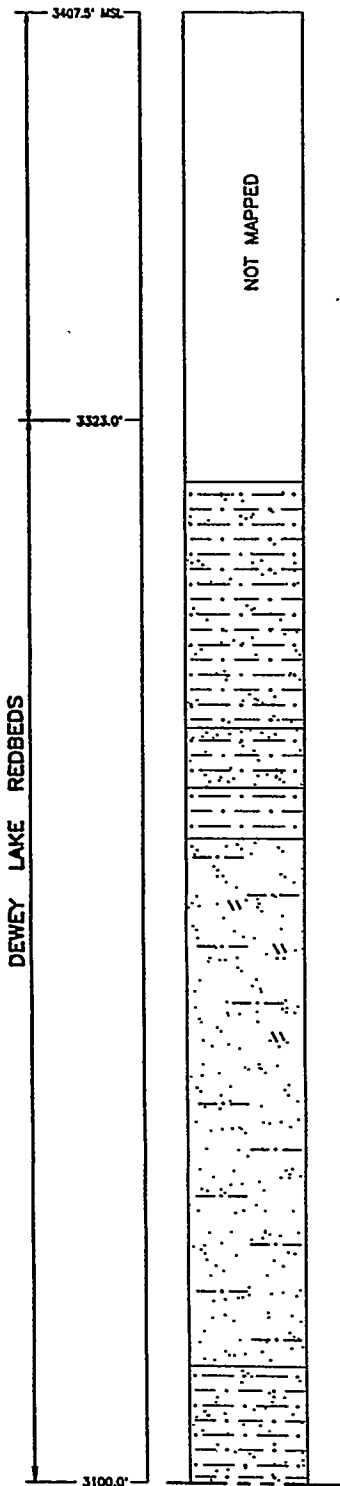

RUSTLER FORMATION



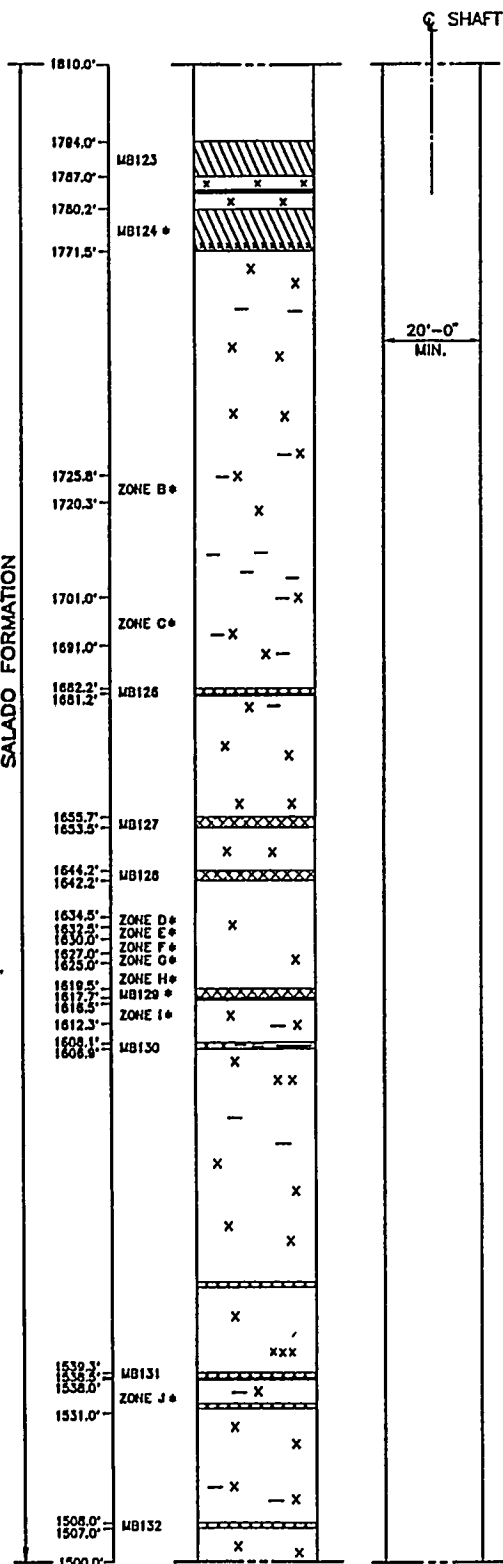

SALADO FORMATION




Albert W. Dennis
8-2-96

NOTES:



- SEE SHT. 1 FOR GENERAL NOTES AND ABBREVIATIONS.
- SEE SHT. 2 FOR LITHOLOGY AND NOTES.


SCALE IN FEET
0 10 20 30 40 50

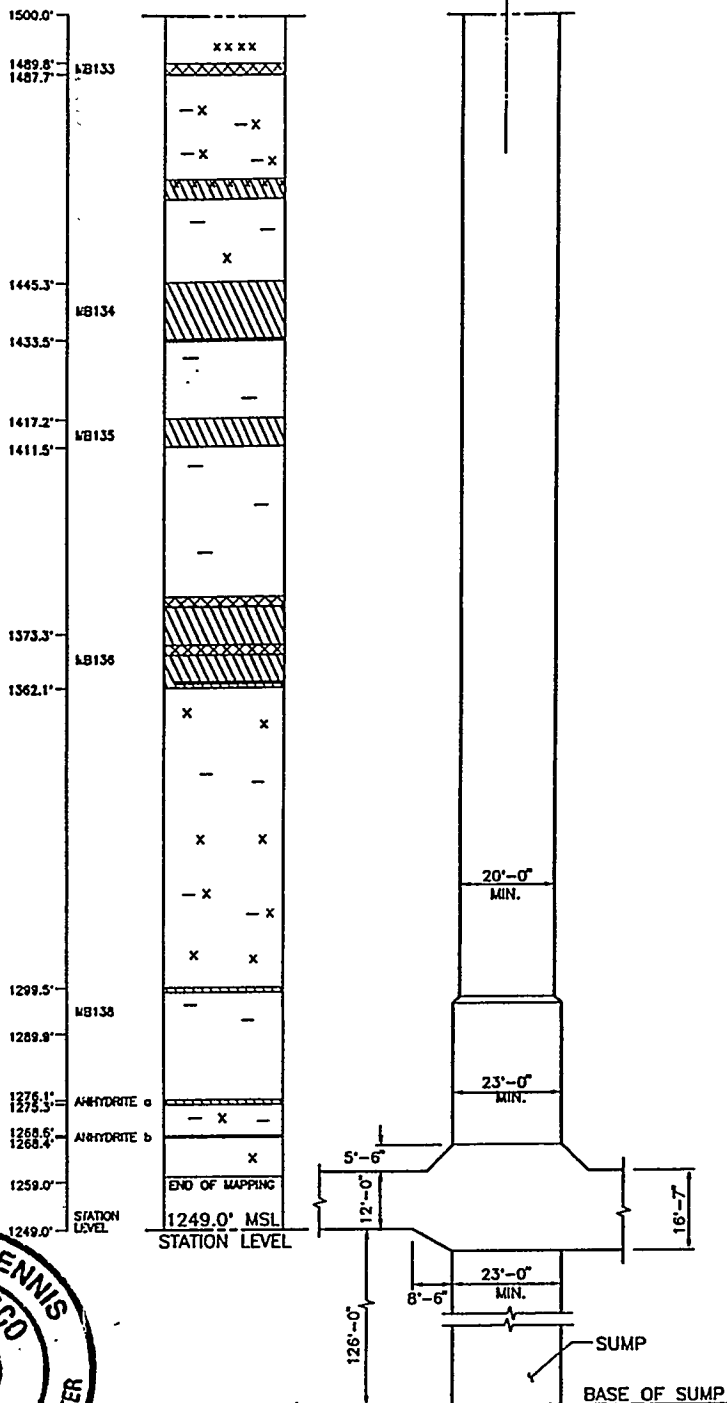

0	8/2/96	ISSUED FOR RECORDS PACKAGE	BY	CK	APP
REV.	DATE	DESCRIPTION	BY	CK	APP
SANDIA NATIONAL LABORATORIES WIPP A/E SUPPORT WIPP SHAFT SEALING SYSTEM SALADO FORMATION WASTE SHAFT STRATIGRAPHY & AS-BUILT ELEMENTS					
CONTRACT NO: AG-4909			NAME		
DATE			DATE		
BY			DATE		
CK			DATE		
APP			DATE		
APP			DATE		
PARSONS BRINCKERHOFF ENERGY SERVICES, INC			SCALE: SIZE B		
SNL DWG. NO. SNL-007			SHEET NO. 3 OF 28		

STRATIGRAPHY (SEE NOTE 2)

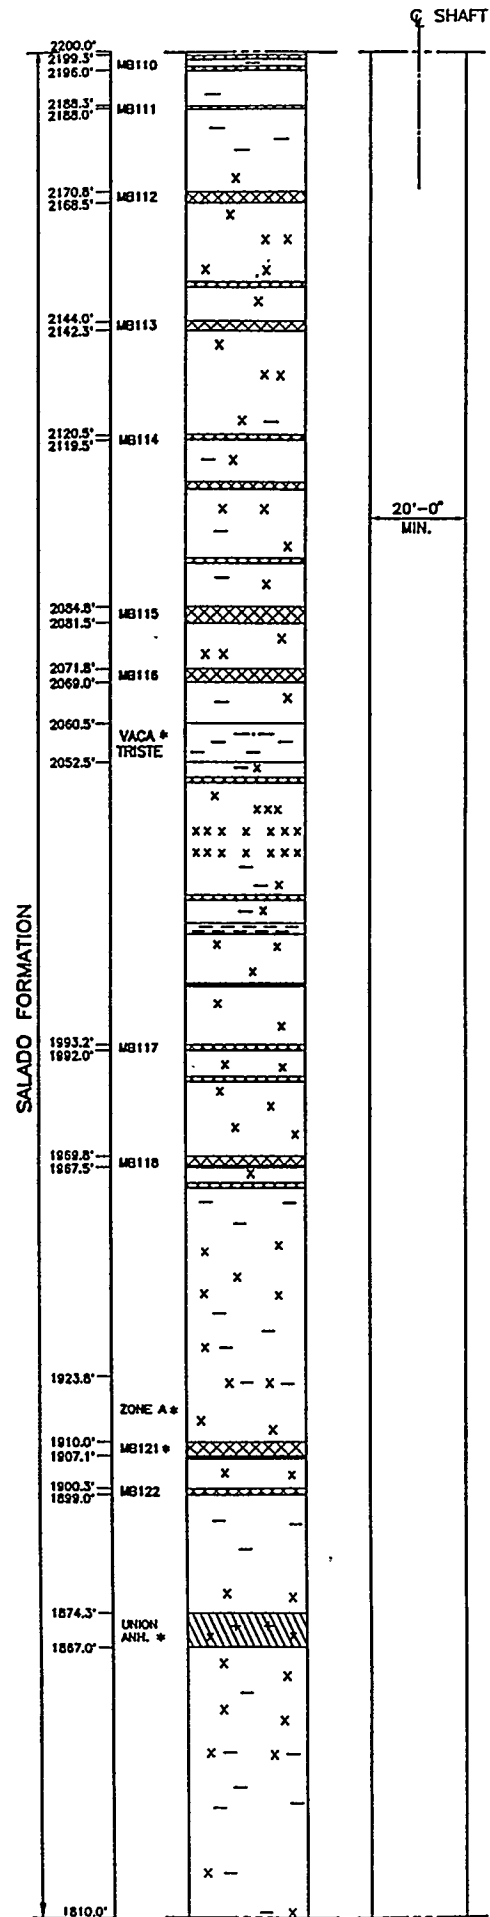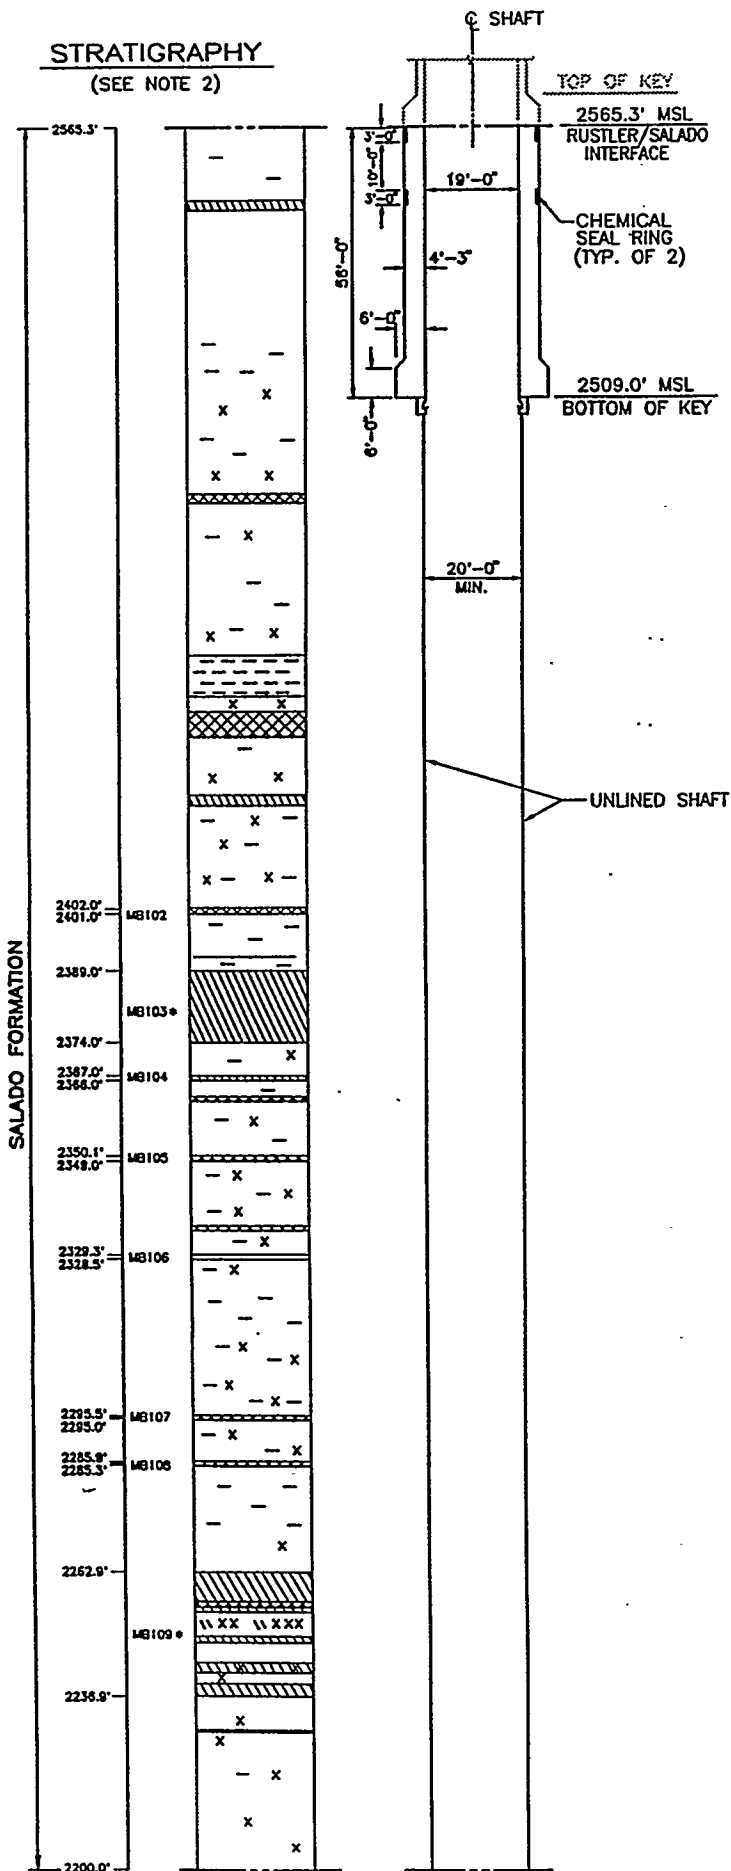

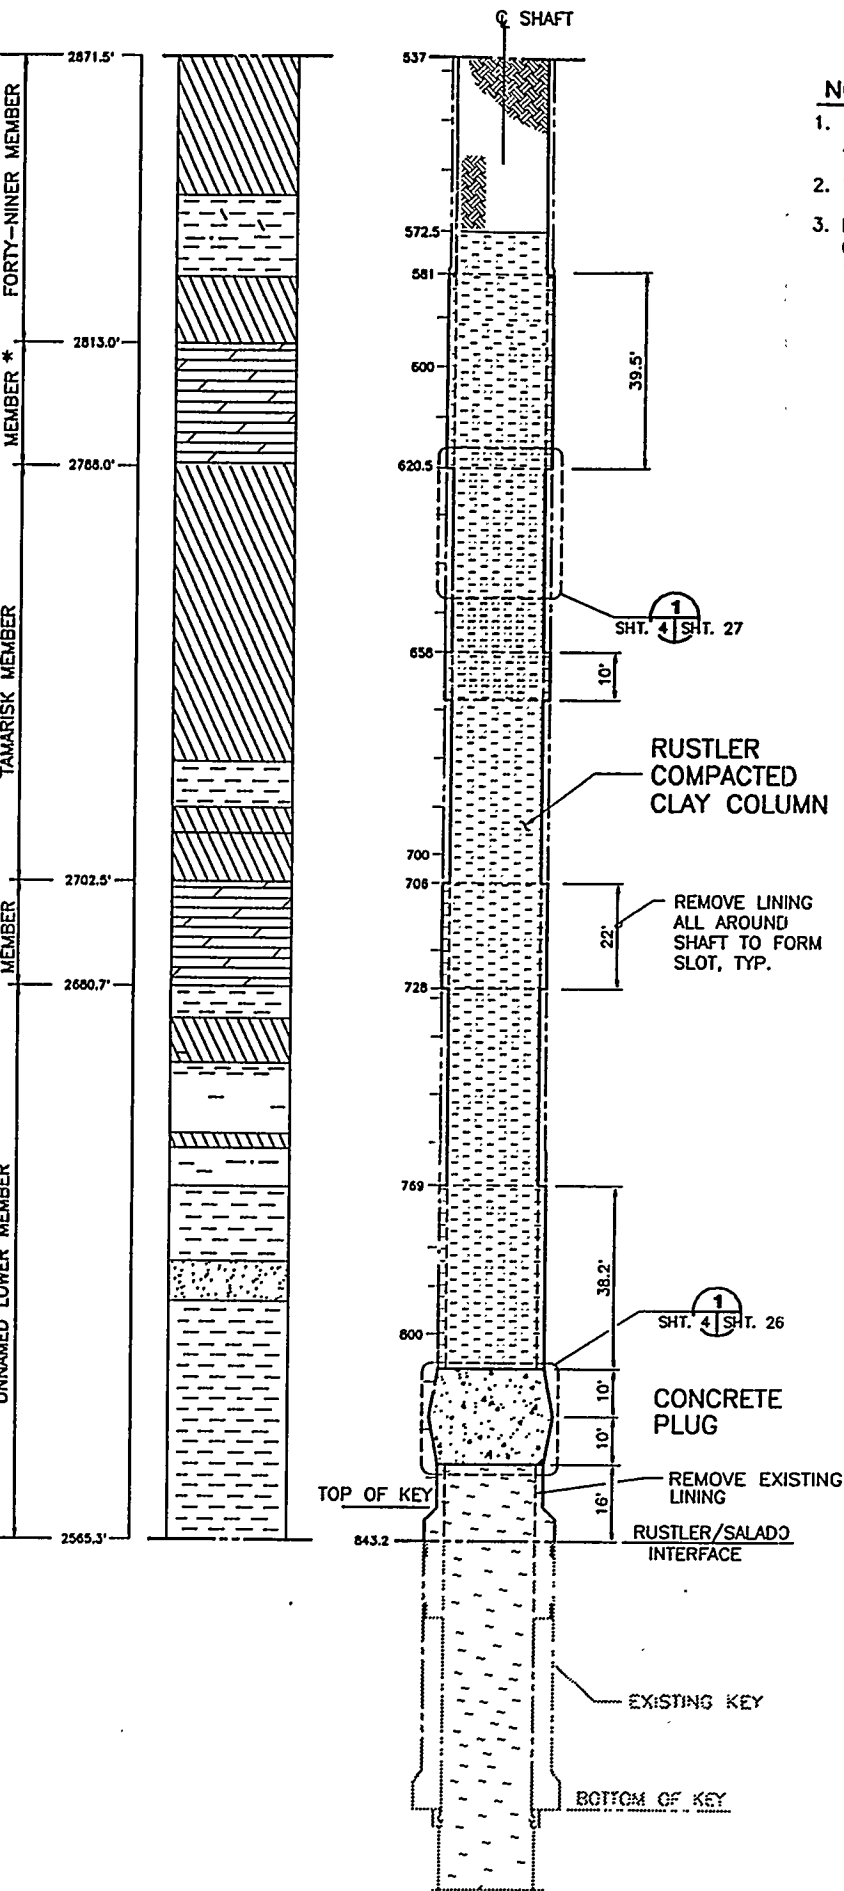


NOTES:

1. SEE SHT. 1 FOR GENERAL NOTES, LEGEND AND ABBREVIATIONS.
2. SEE SHT. 2 FOR LITHOLOGY AND NOTES.
3. DEPTHS SHOWN ARE DISTANCES BELOW THE TOP OF CONCRETE, LOCATED AT EL. 3408.5' ABOVE MSL USGS 1927 NORTH AMERICAN DATUM.



Albert W. Dennis
8-2-96

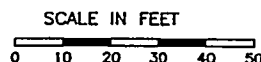

0	8/2/96	ISSUED FOR RECORDS PACKAGE	BY	CK	APP
REV.	DATE	DESCRIPTION	BY	CK	APP
SANDIA NATIONAL LABORATORIES WIPP A/E SUPPORT WIPP SHAFT SEALING SYSTEM NEAR-SURFACE/RUSTLER FORMATIONS WASTE SHAFT STRATIGRAPHY & SEALING SUBSYSTEM PROFILE					
CONTRACT NO: AG-4909			NAME	DATE	
			BY	8/4/96	
			CK	8/4/96	
			APP	8/4/96	
			APP	8/4/96	
PARSONS BRINCKERHOFF ENERGY SERVICES, INC			SCALE:	SIZE B	SNL DWG. NO. SNL-007
			SHEET NO. 4 OF 28		

STRATIGRAPHY


(SEE NOTE 2)


SHAFT

DEPTH
(SEE NOTE 3)

SHAFT



TOP OF CONCRETE
EL. 3408.5' MSL

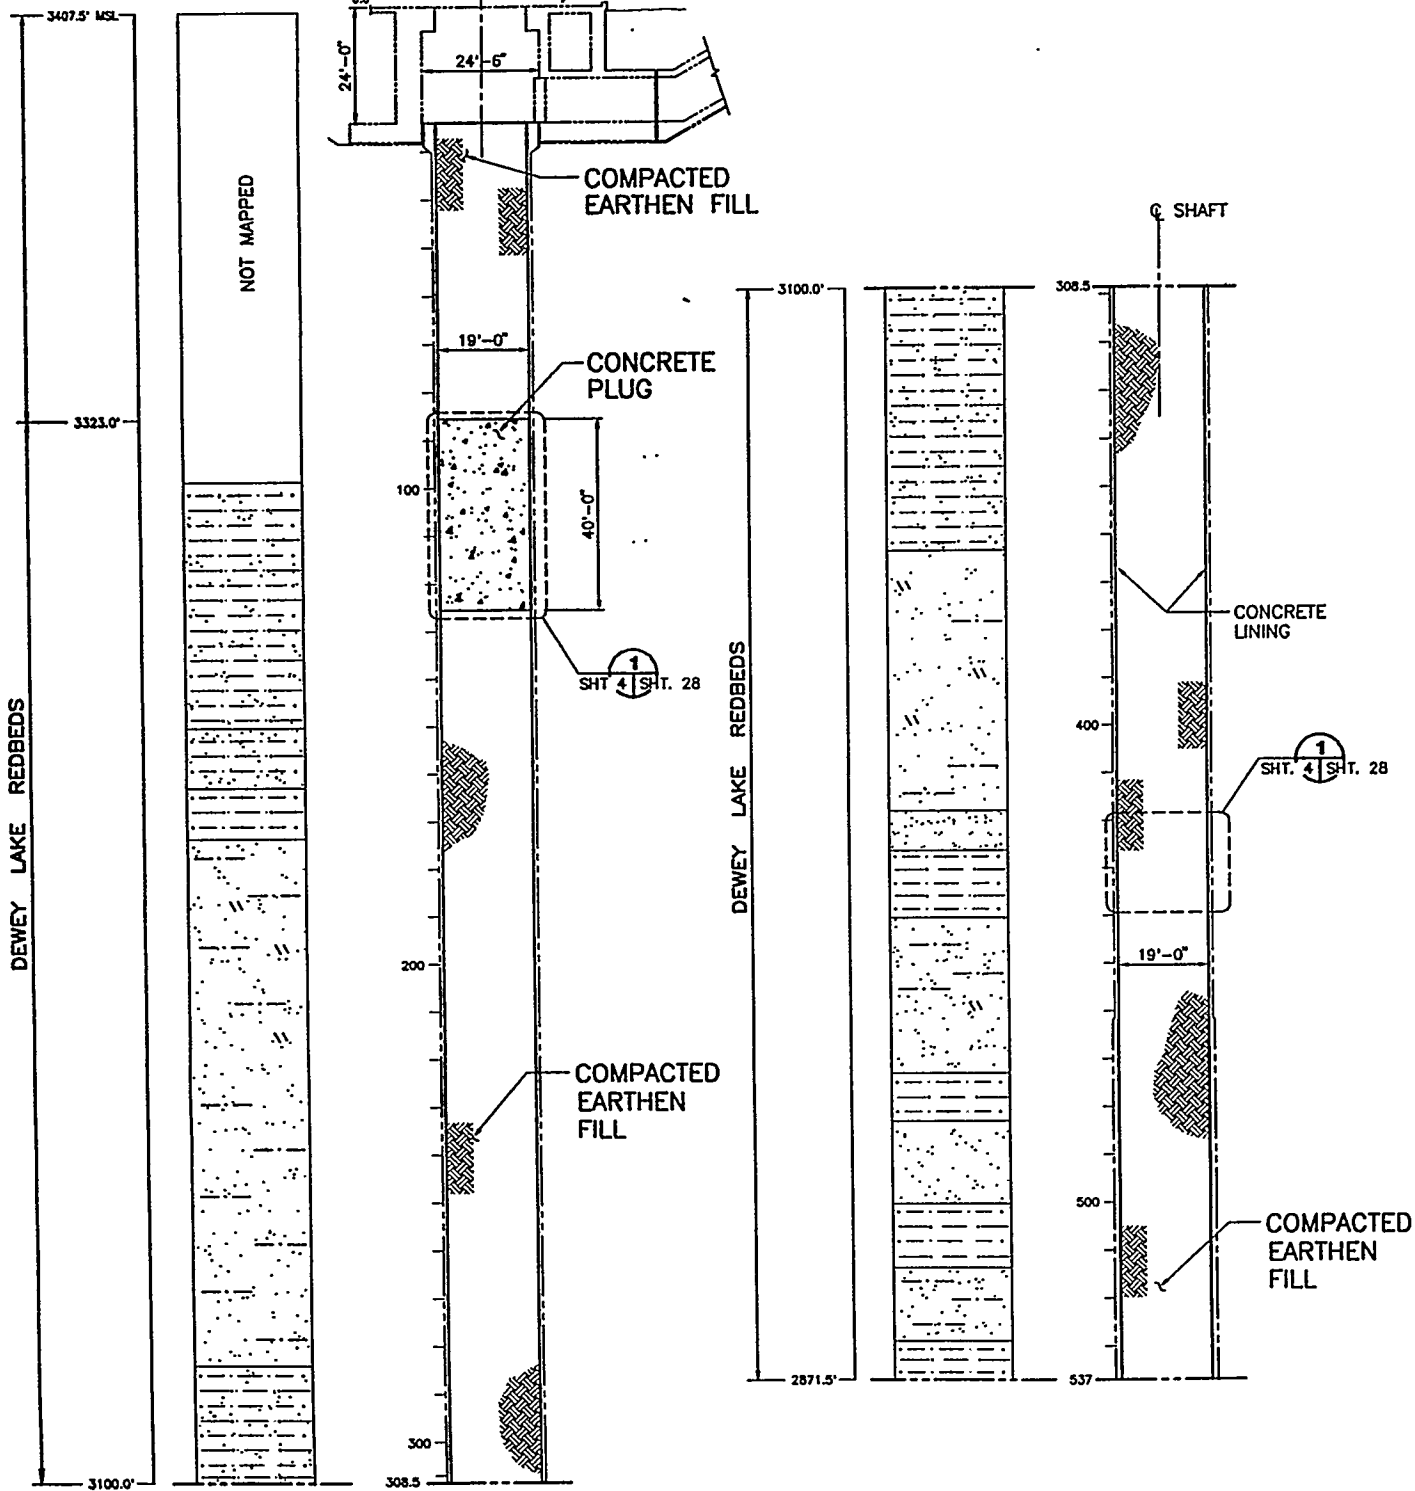


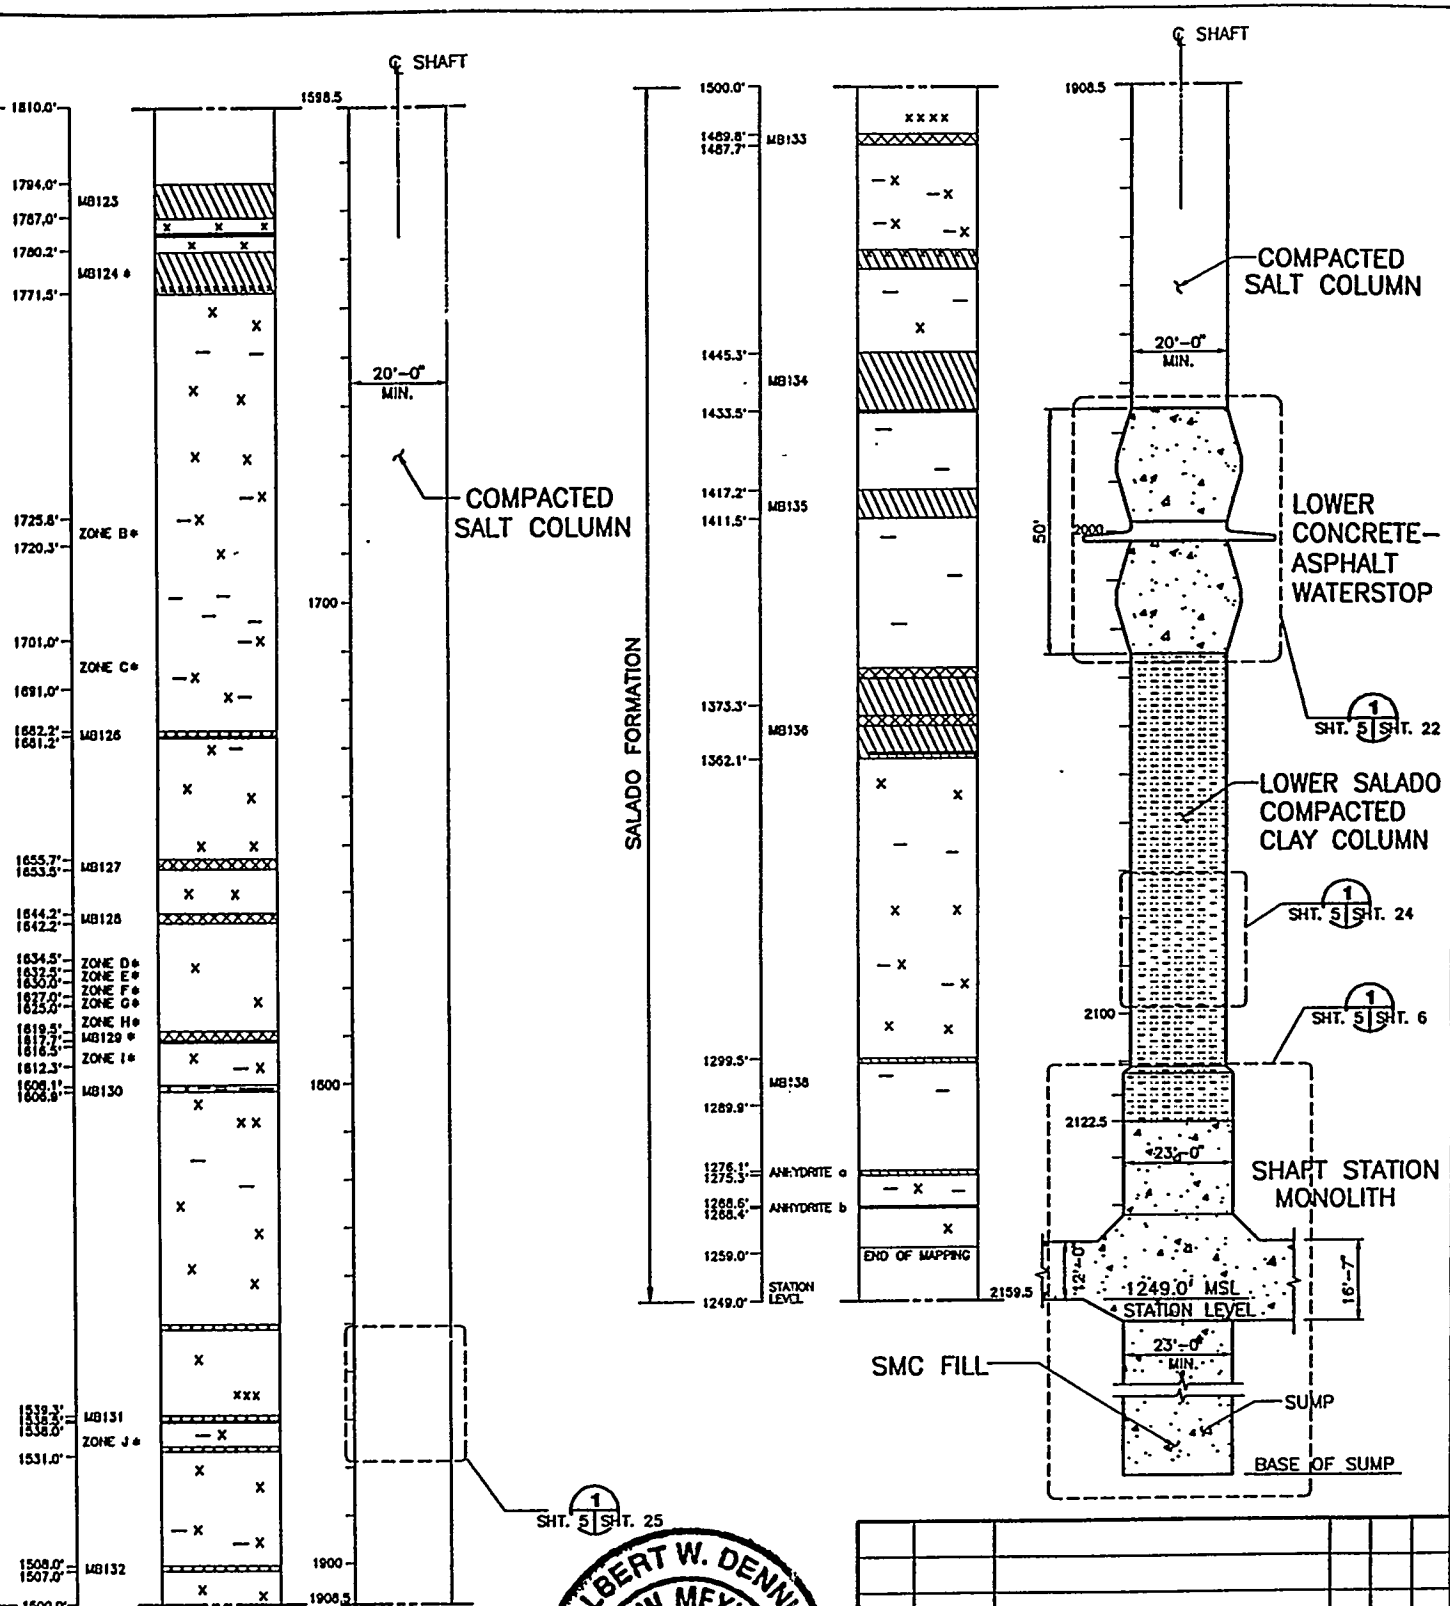

STRATIGRAPHY

(SEE NOTE 2)

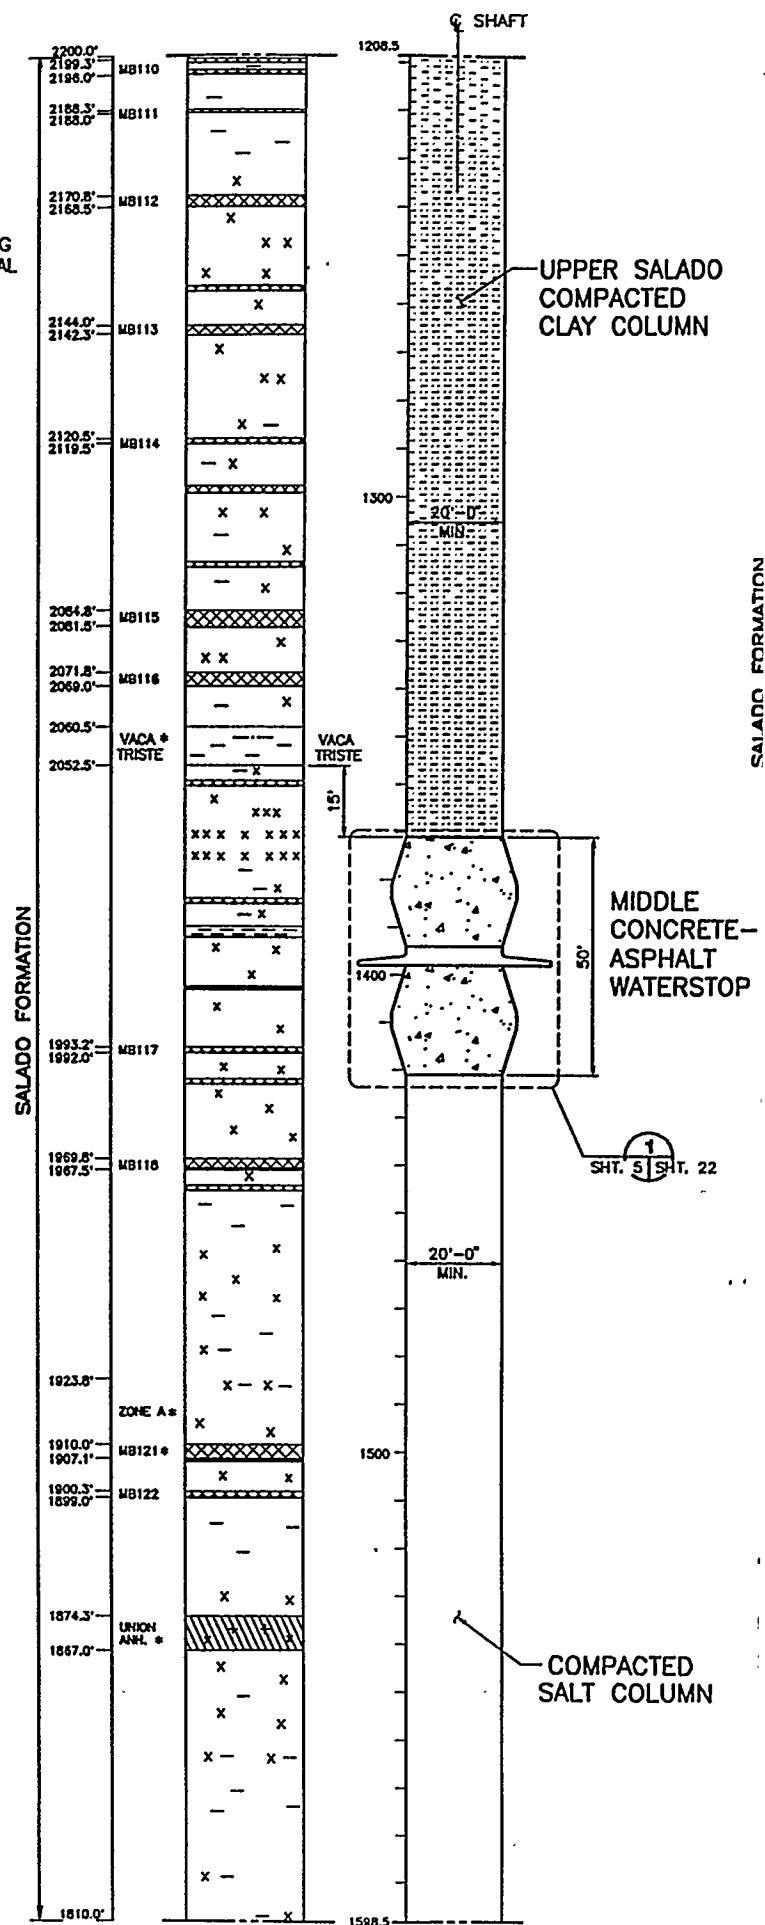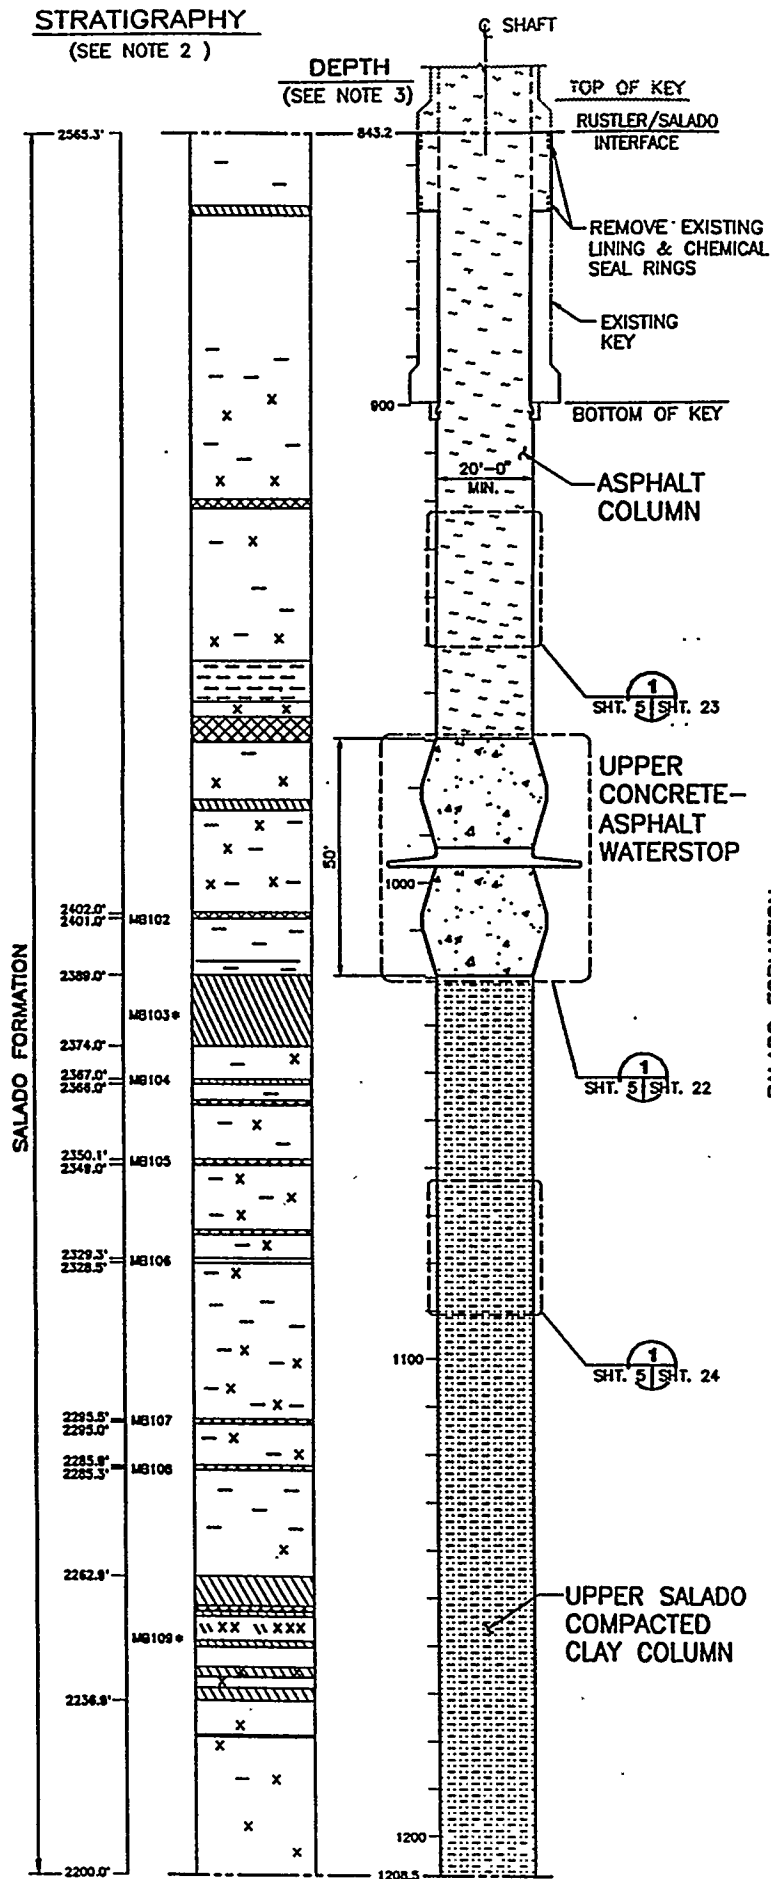

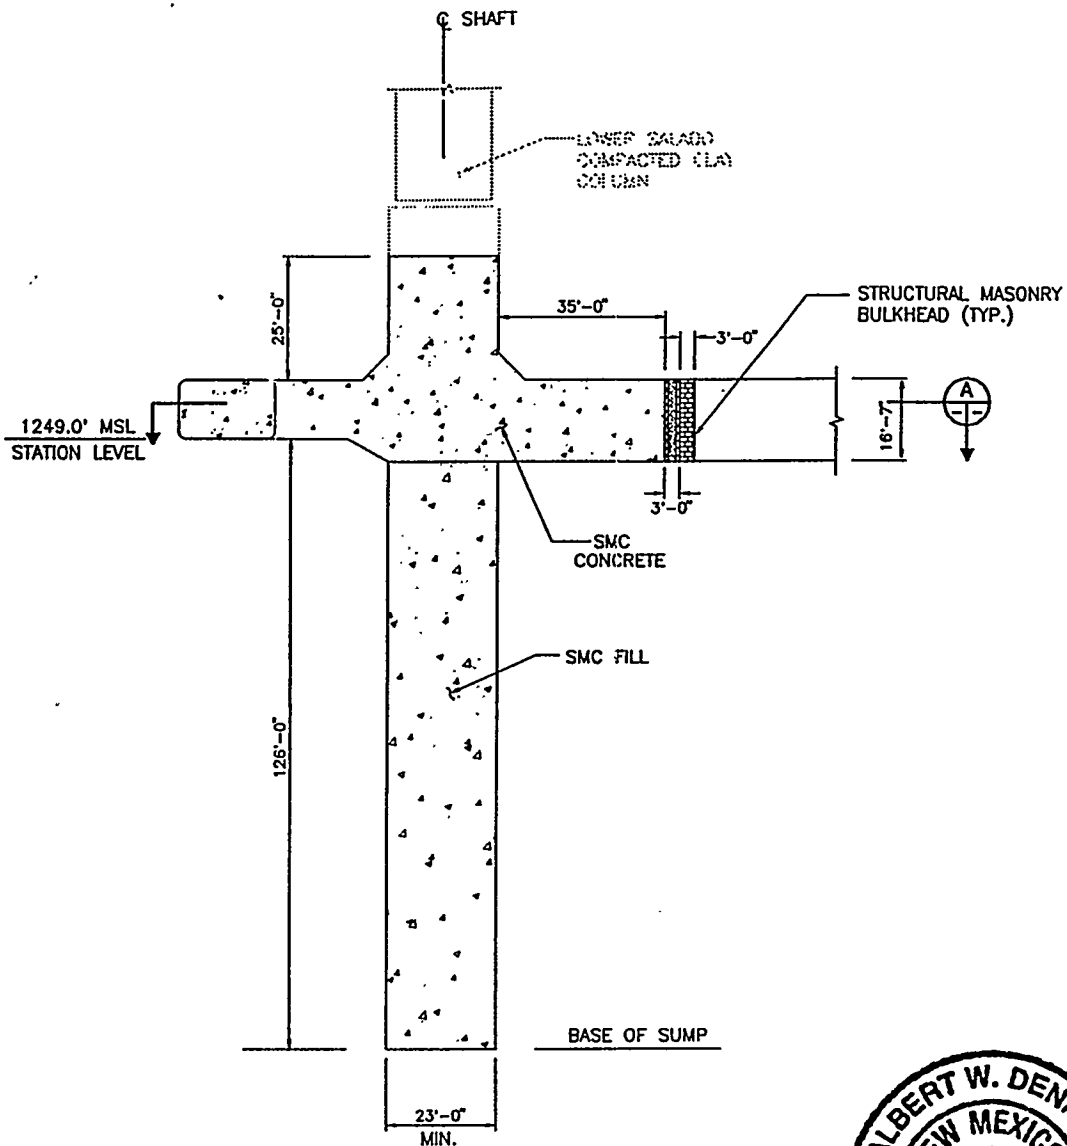

DETAIL

SHT. 5 | SHT. 6




Albert W. Dennis
8-2-96

GENERAL NOTES, LEGEND AND

SCALE IN FEET
0 10 20 30 40 50

0	8/2/96	ISSUED FOR RECORDS PACKAGE	BY	CK.	APP.
REV.	DATE	DESCRIPTION	BY	CK.	APP.
SANDIA NATIONAL LABORATORIES					
WIPP A/E SUPPORT			CONTRACT NO: AC-4909		
WIPP SHAFT SEALING SYSTEM			NAME	DATE	
WASTE SHAFT SHAFT STATION MONOLITH			BY	8/2/96	
			CK.	8/2/96	
			APP.	8/2/96	
			APP.	8/2/96	
PARSONS BRINCKERHOFF ENERGY SERVICES, INC			SCALE:	SIZE	SNL DWG. NO.
			8	B	SNL-007
					SHEET NO.
					6 OF 28

E-9

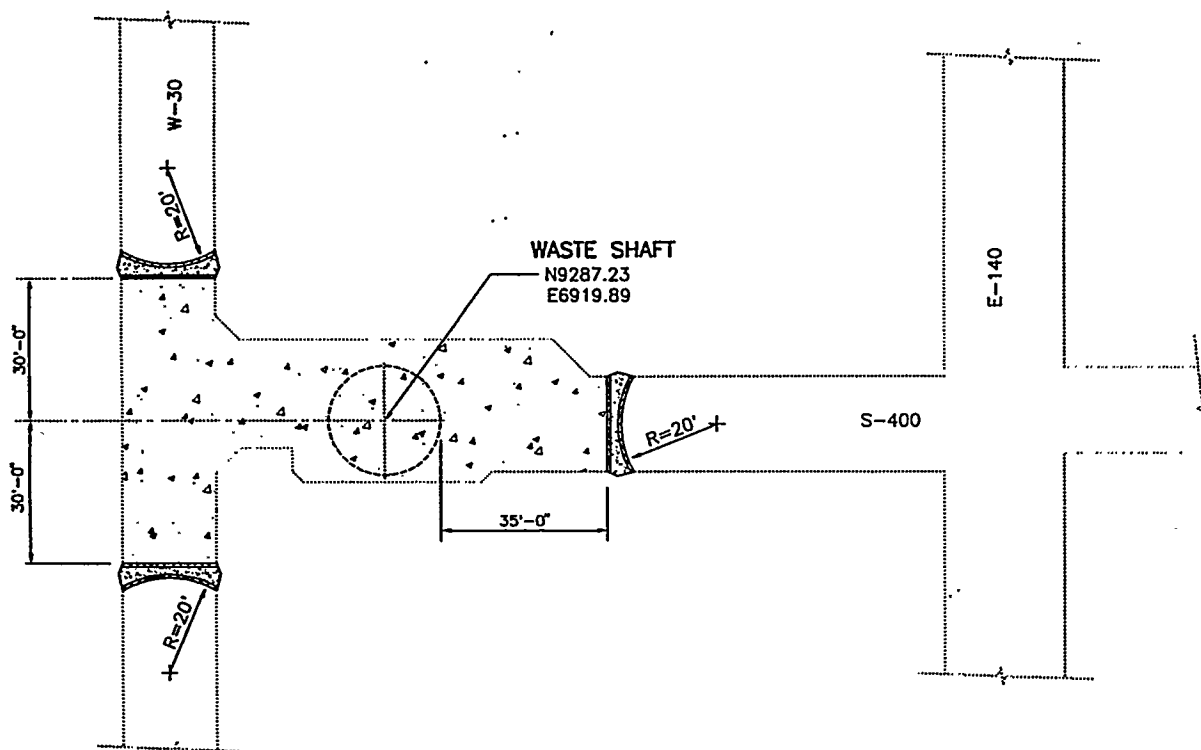


SECTION



NOTES:

1. SEE SHT. 1 FOR GEOMETRIC ABBREVIATIONS.

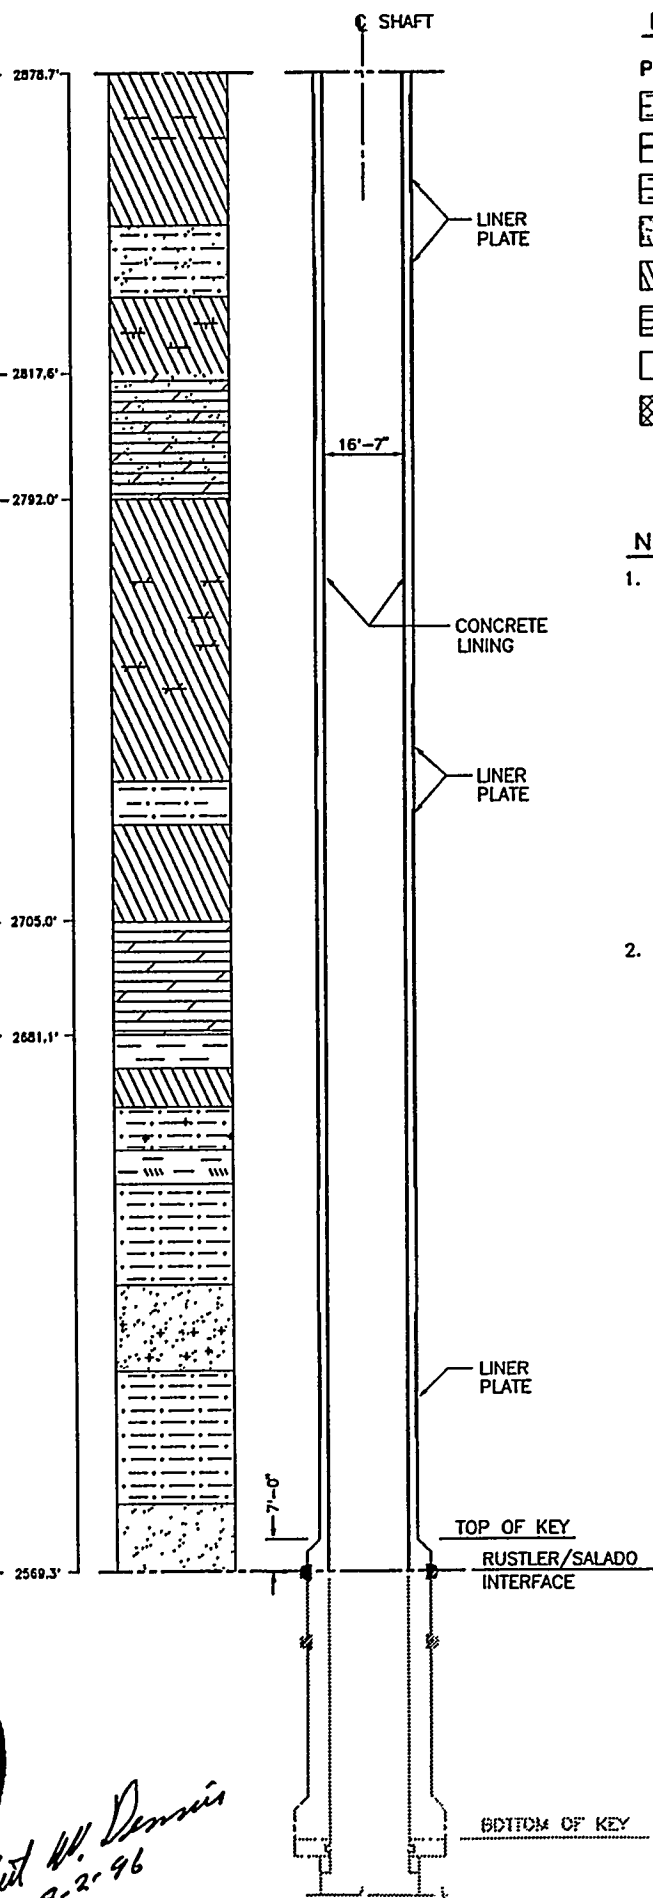

LITHOLOGY:

PRIMARY ROCK/SEDIMENT TYPES

	MUDSTONE/CLAYSTONE
	CLAYSTONE BED
	SILTSTONE
	SANDSTONE
	ANHYDRITE/GYPSUM
	DOLOMITE
	HALITE
	POLYHALITE

SECONDARY CONSTITUENTS

	ARGILLACEOUS
	SILTY
	SANDY
	SULFATIC
	DOLOMITIC
	CALCAREOUS
	HALITIC
	POLYHALITIC
	LANGBEINITE

NOTES:


- THE STRATIGRAPHY AND GROUNDWATER BRINE SEEPAGE/WEEP INTERVALS ARE BASED ON THE LITHOLOGIC INFORMATION COMPILED DURING THE GEOLOGIC MAPPING OF THE AIR INTAKE SHAFT WALLS, DOE/WIPP-90-051, "GEOLOGIC MAPPING OF THE AIR INTAKE SHAFT AT THE WASTE ISOLATION PILOT PLANT", 1990, AND APPENDIX A OF REPORT DOE/WIPP-95-3117, "WASTE ISOLATION PILOT PLANT SEALING SYSTEM DESIGN REPORT", 1995.

ASTERISK(*) INDICATES GROUNDWATER (RUSTLER/SUPRA RUSTLER FORMATIONS) OR BRINE SEEPAGE/WEEPS (SALADO FORMATION) OBSERVED DURING THE MAPPING OF THE AIR INTAKE SHAFT. AS OF 1994, ONLY MB103 SHOWED VISIBLE MOISTURE ON THE SALADO FORMATION SURFACE EXPOSED WITHIN THE AIR INTAKE SHAFT, "BRINE SAMPLING EVALUATION PROGRAM 1992-1993 REPORT," 1994, DOE-WIPP 94-011.

- REFERENCE AS-BUILT DRAWINGS FROM WID:

AIR INTAKE SHAFT 331 SHAFT COLLAR / AIR INTAKE PLENUM PLAN, SECTIONS AND DETAILS.	33-C-001-W
AIR INTAKE SHAFT 331 SHAFT COLLAR / AIR INTAKE PLATFORM PLAN, SECTIONS AND DETAILS.	33-C-002-W
AIR INTAKE SHAFT 331 STRUCTURE PLAN, SECTIONS AND DETAILS	33-C-003-W1
AIR INTAKE SHAFT 331 SHAFT KEY PLAN, SECTIONS AND DETAILS	33-C-004-W1
AIR INTAKE SHAFT 331 LINING DETAILS	33-C-005-W
AIR INTAKE SHAFT 331 EXCAVATION AS-BUILT	33-D-002-W
AIR INTAKE SHAFT 331 GENERAL ARRANGEMENT	33-D-008-W
AIR INTAKE SHAFT 331 SHAFT STATION PLAN, SECTIONS AND DETAILS	51-W-212-W

 SCALE IN FEET






0	8/2/96	ISSUED FOR RECORDS PACKAGE	BY	CK	APP
REV.	DATE	DESCRIPTION	BY	CK	APP
SANDIA NATIONAL LABORATORIES					
WIPP A/E SUPPORT			CONTRACT NO: AG-4909		
WIPP SHAFT SEALING SYSTEM			NAME	DATE	
NEAR-SURFACE/RUSTLER FORMATIONS			BY	8/2/96	
AIR INTAKE SHAFT			CK	8/2/96	
STRATIGRAPHY &			APP	8/2/96	
AS-BUILT ELEMENTS			APP	8/2/96	
PARSONS BRINCKERHOFF ENERGY SERVICES, INC		SCALE: B	SIZE	SNL DWG. NO. SNL-007	SHEET NO. 7 OF 28

E-10

8-2-96

STRATIGRAPHY (SEE NOTE 1)

SHAFT

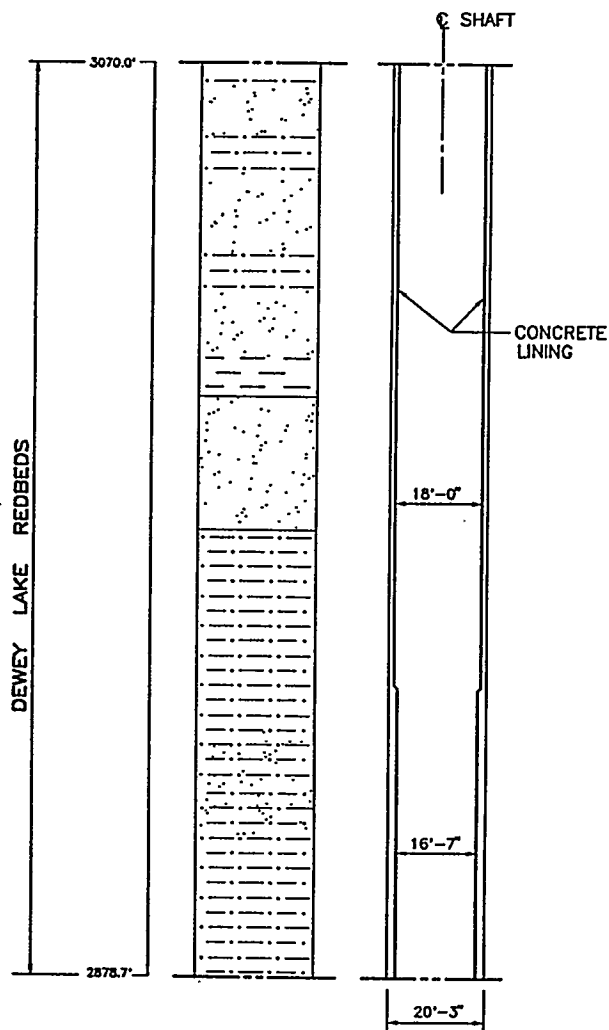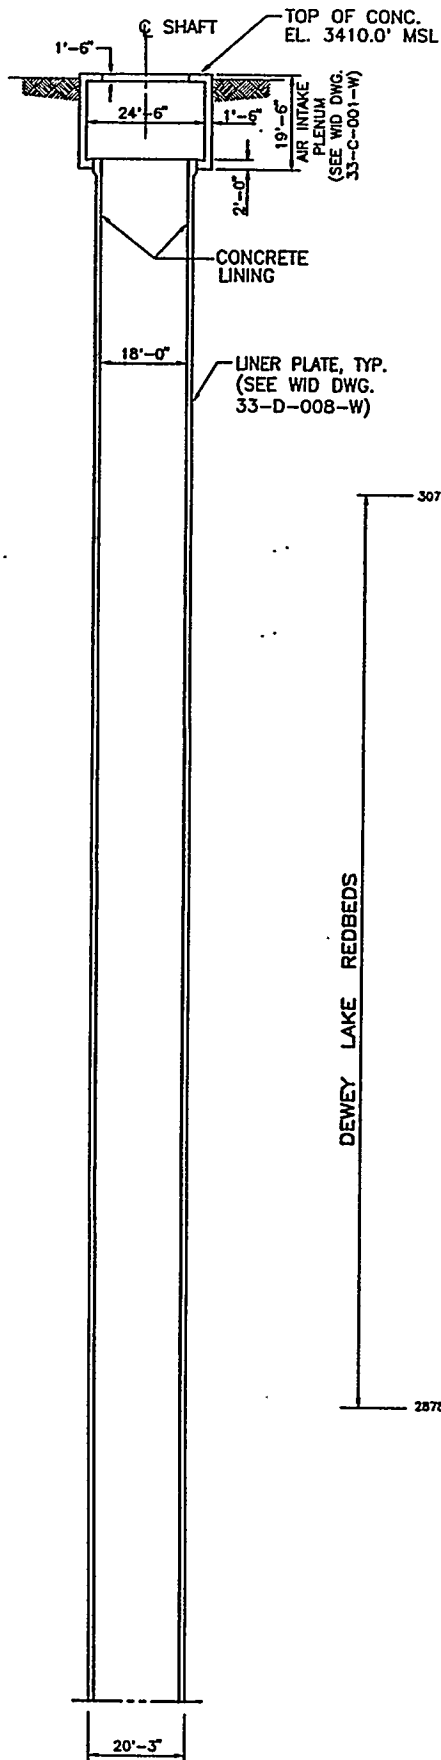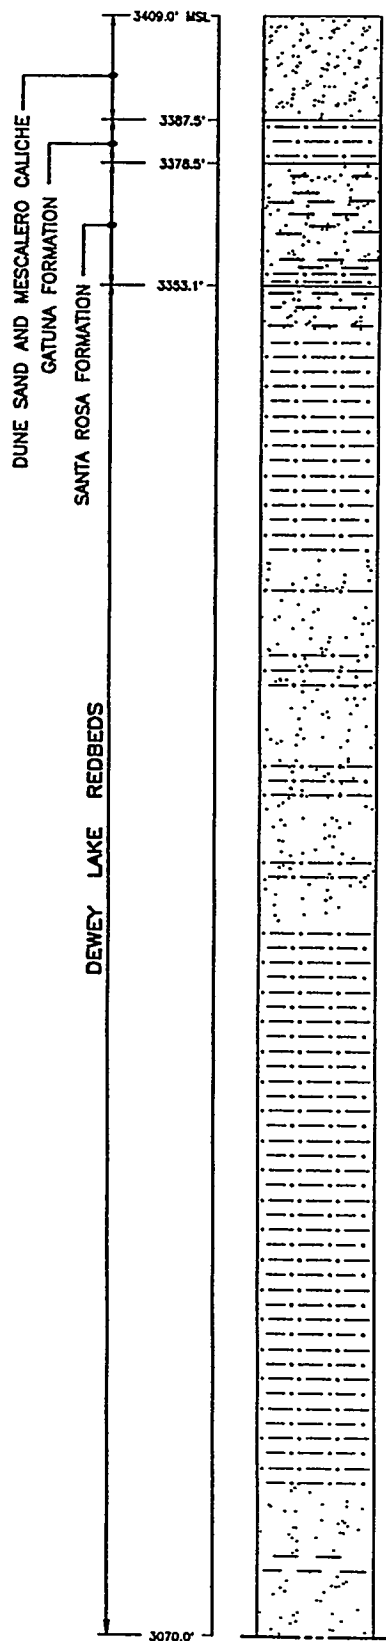

RUSTLER FORMATION

FORTY-NINER MEMBER


MAGENTA * MEMBER

TAMARISK MEMBER

CULEBRA * MEMBER


UNNAMED LOWER MEMBER




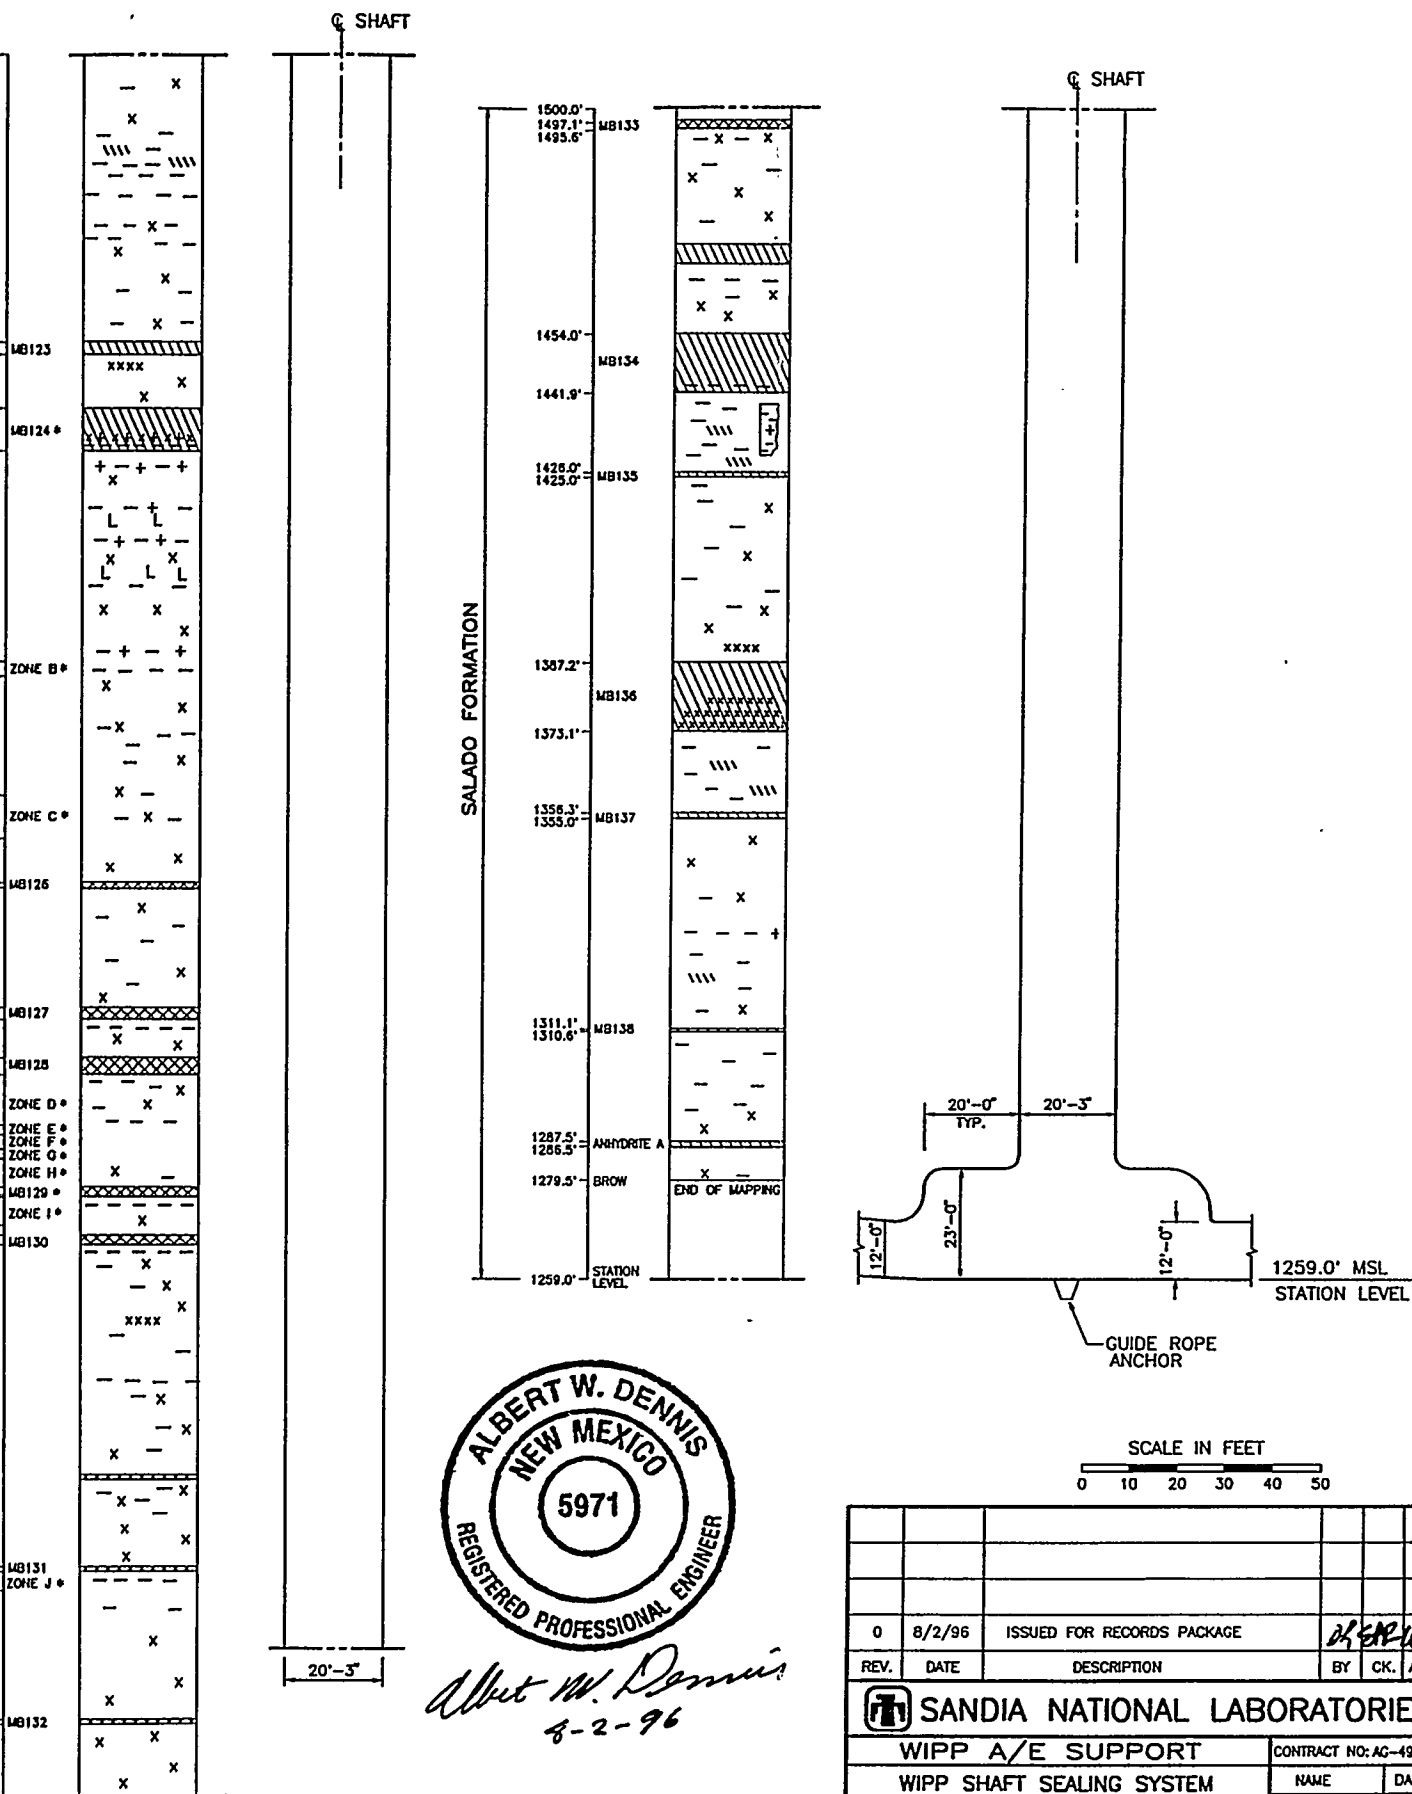


STRATIGRAPHY

(SEE NOTE 2)

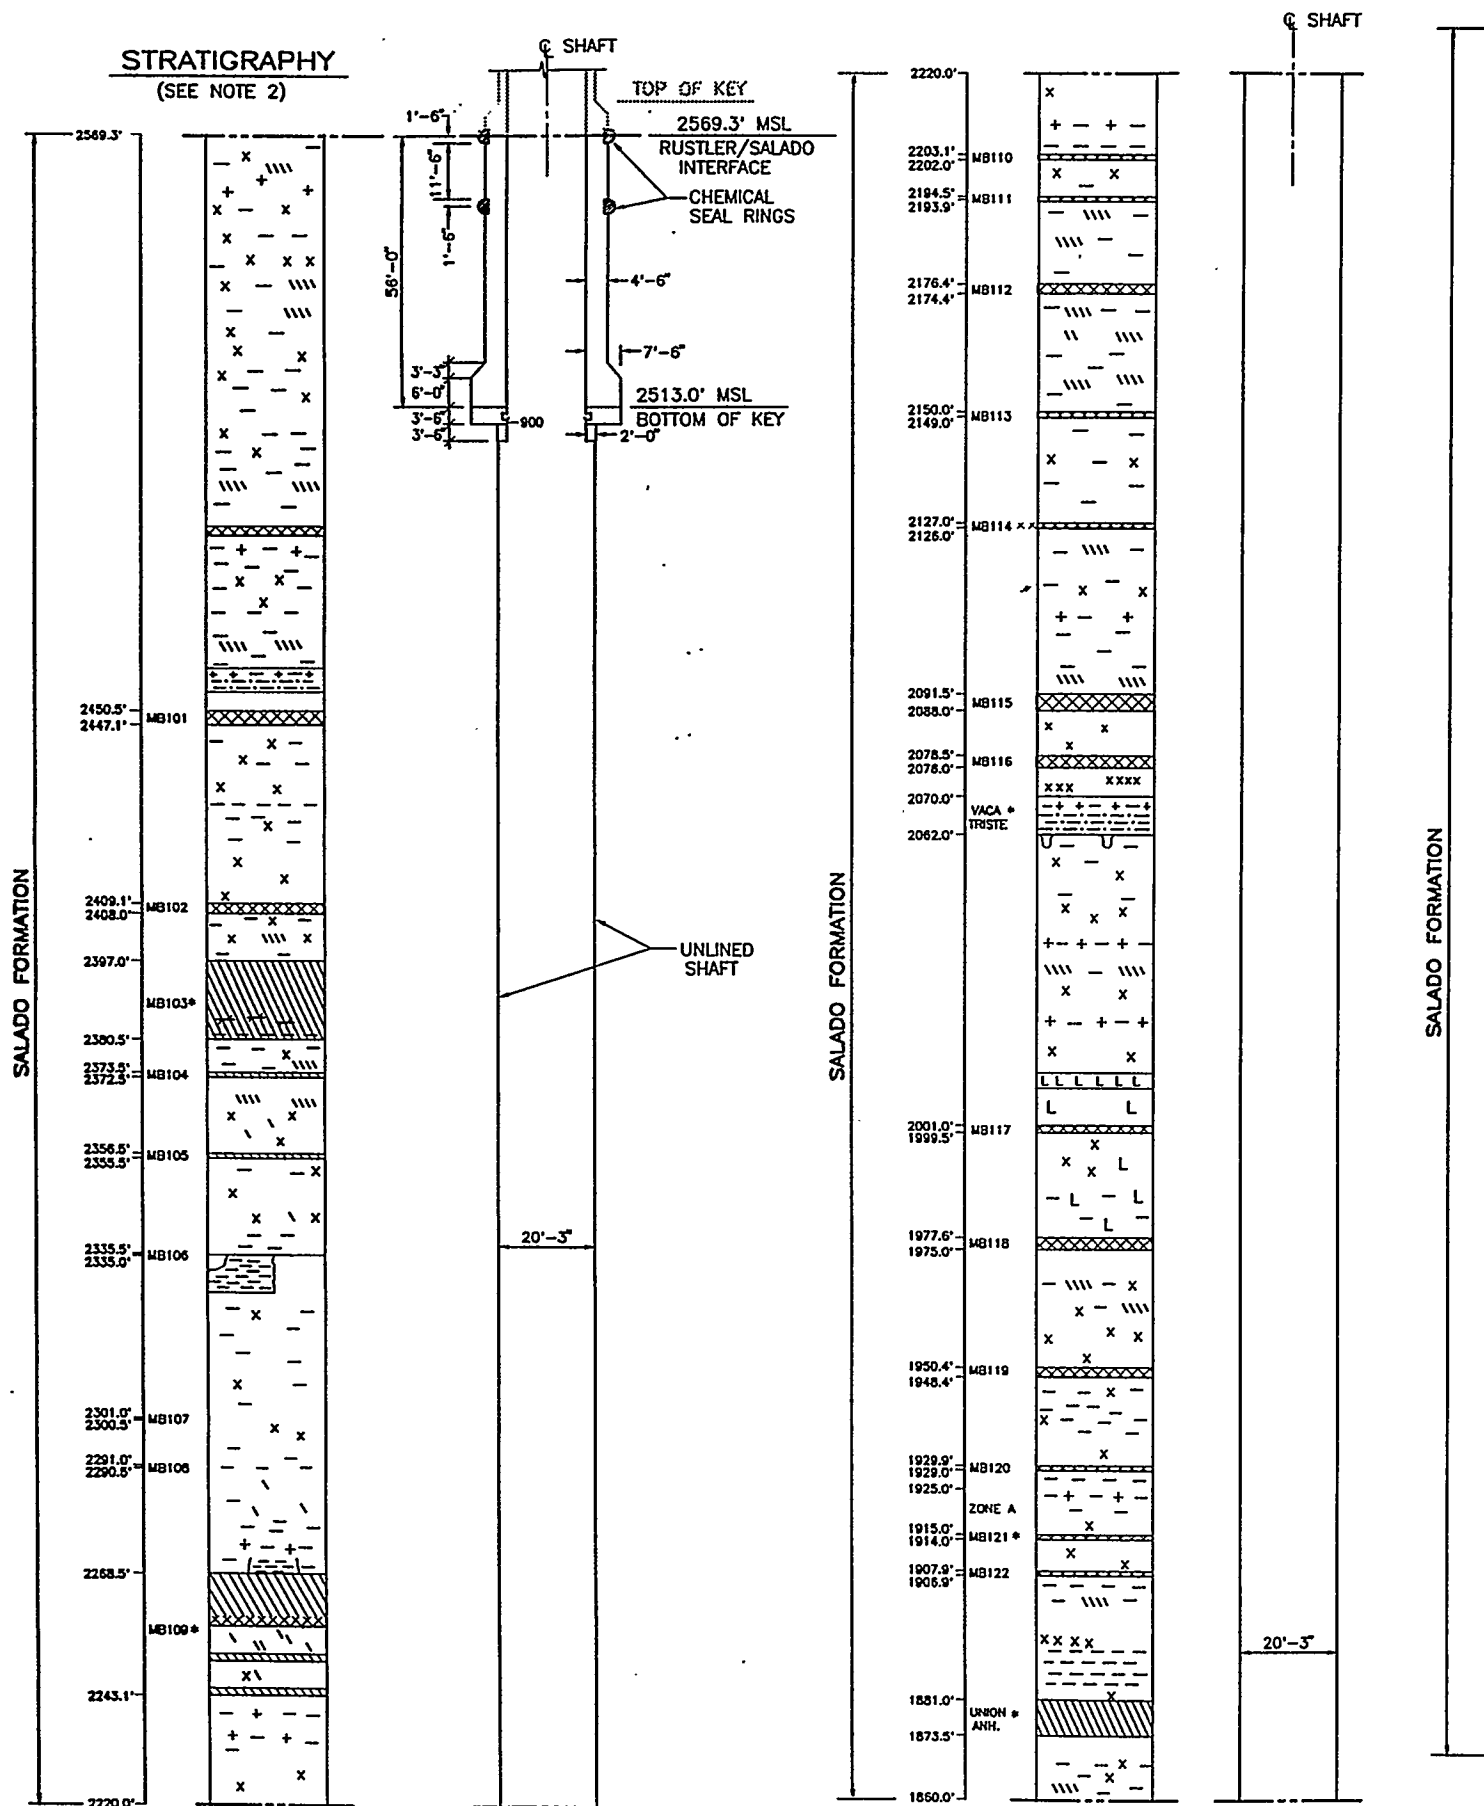

RUSTLER FORMATION

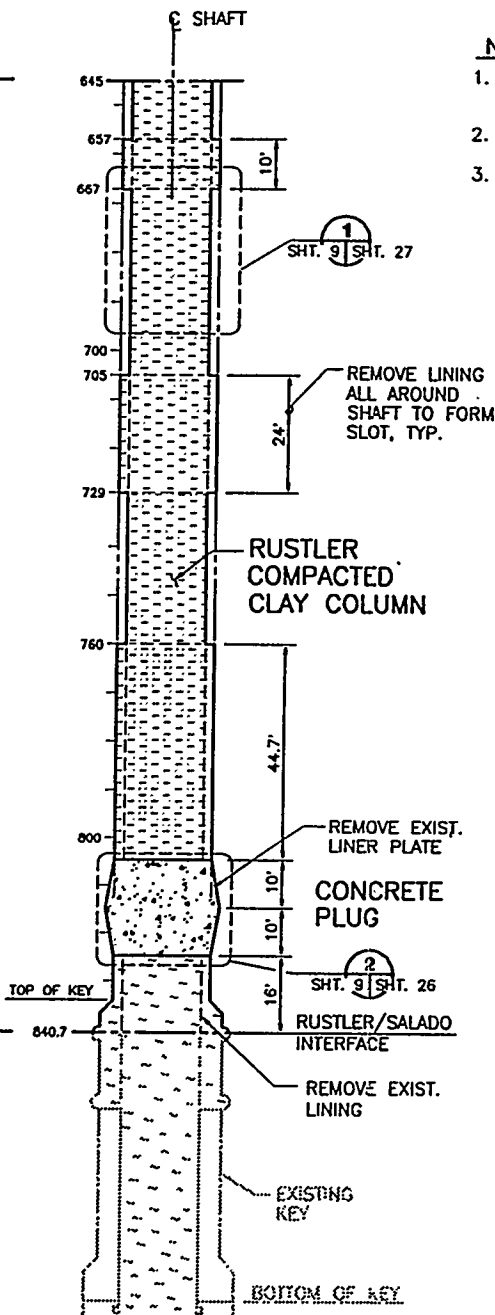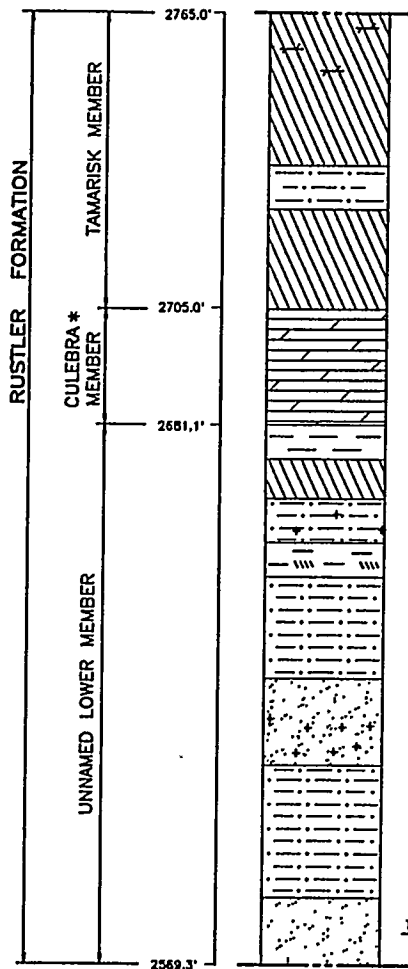


NOTES:

1. SEE SHT. 1 FOR GENERAL NOTES, LEGEND AND ABBREVIATIONS
2. SEE SHT. 7 FOR LITHOLOGY AND NOTES.
3. DEPTHS SHOWN ARE DISTANCES BELOW THE TOP OF CONCRETE, LOCATED AT EL. 3410.0' ABOVE MSL USGS 1927 NORTH AMERICAN DATUM.




Albert W. Dennis
8-2-96

 SCALE IN FEET



0	8/2/96	ISSUED FOR RECORDS PACKAGE	BY	CK.	APP.
REV.	DATE	DESCRIPTION	BY	CK.	APP.
SANDIA NATIONAL LABORATORIES					
WIPP A/E SUPPORT			CONTRACT NO: AG-4909		
WIPP SHAFT SEALING SYSTEM NEAR-SURFACE/RUSTLER FORMATIONS AIR INTAKE SHAFT STRATIGRAPHY AND SEALING SUBSYSTEM PROFILE			NAME	DATE	
			BY	8/2/96	
			CK.	8/2/96	
			APP.	8/2/96	
			APP.	8/2/96	
			APP.	8/2/96	
PARSONS BRINCKERHOFF ENERGY SERVICES, INC	SCALE:	SIZE	SNL DWG. NO.	SHEET NO.	
		B	SNL-007	9 OF 28	

E-12

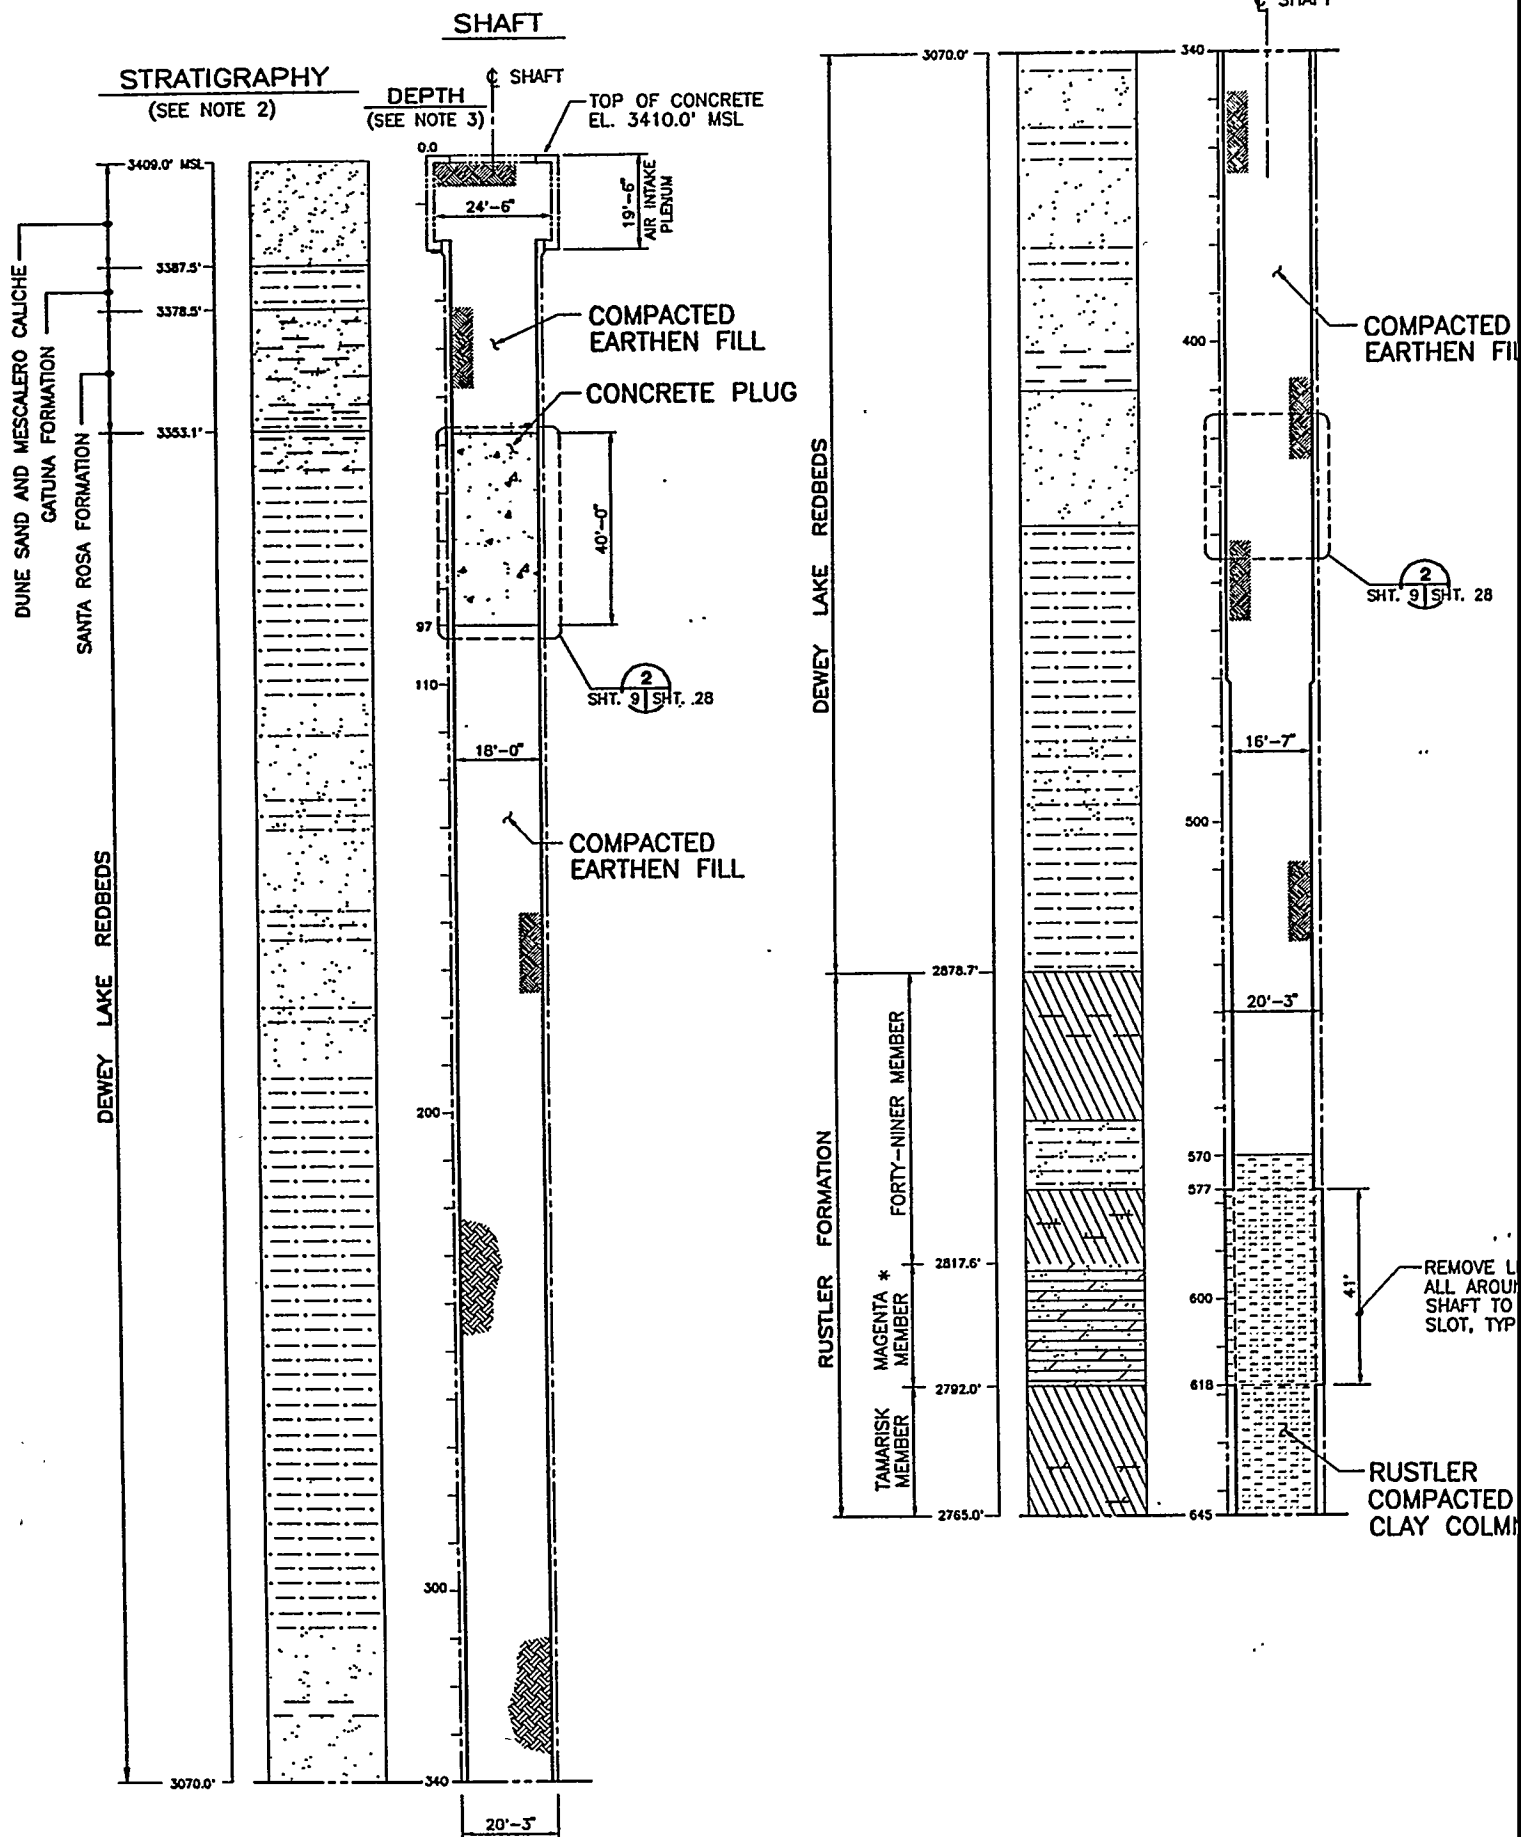





1. SEE SHT. 1 FOR GENERAL NOTES, LEGEND AND ABBREVIATIONS
2. SEE SHT. 7 FOR LITHOLOGY AND NOTES.
3. SEE NOTE 3 OF SHT. 9.

0	8/2/96	ISSUED FOR RECORDS PACKAGE							
REV.	DATE	DESCRIPTION				BY	CK.	APP	
SANDIA NATIONAL LABORATORIES									
WIPP A/E SUPPORT						CONTRACT NO: AG-4909			
WIPP SHAFT SEALING SYSTEM SALADO FORMATION AIR INTAKE SHAFT STRATIGRAPHY AND SEALING SUBSYSTEM PROFILE						NAME	DATE		
						BY	D. Lauer 8/4/96		
						CK.	SAR 8/4/96		
						APP.	MSF 8/4/96		
						APP	C. D. [unclear] 8/12/96		
PARSONS BRINCKERHOFF ENERGY SERVICES, INC						SCALE:	SIZE B	SNL DWG. NO. SNL-007	SHEET NO. 10 OF 28

STRATIGRAPHY
(SEE NOTE 2)

DEPTH
(SEE NOTE 3)

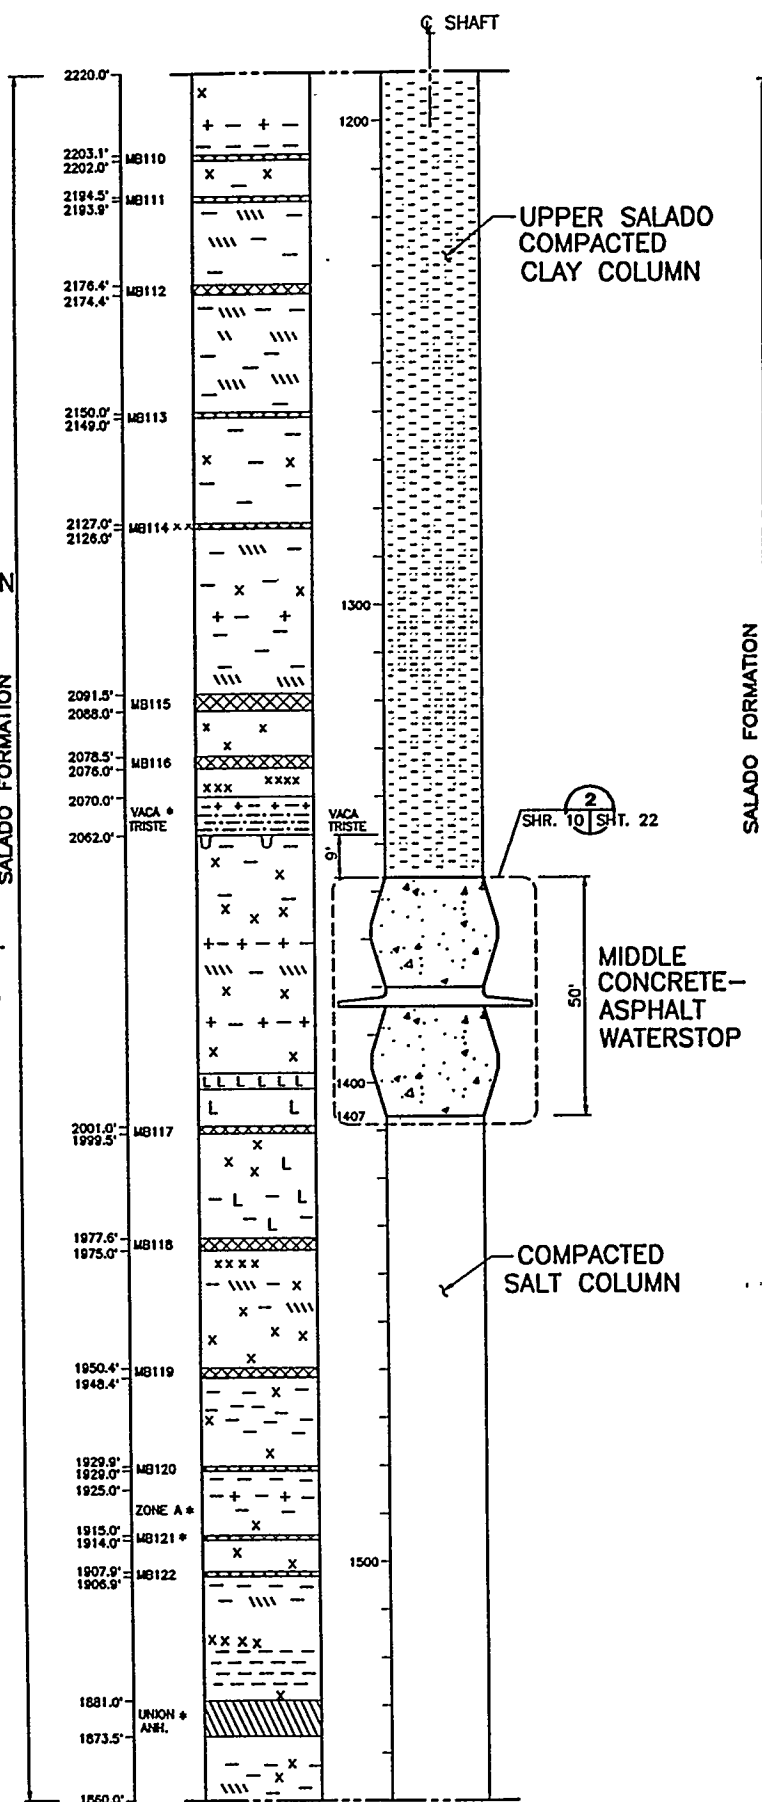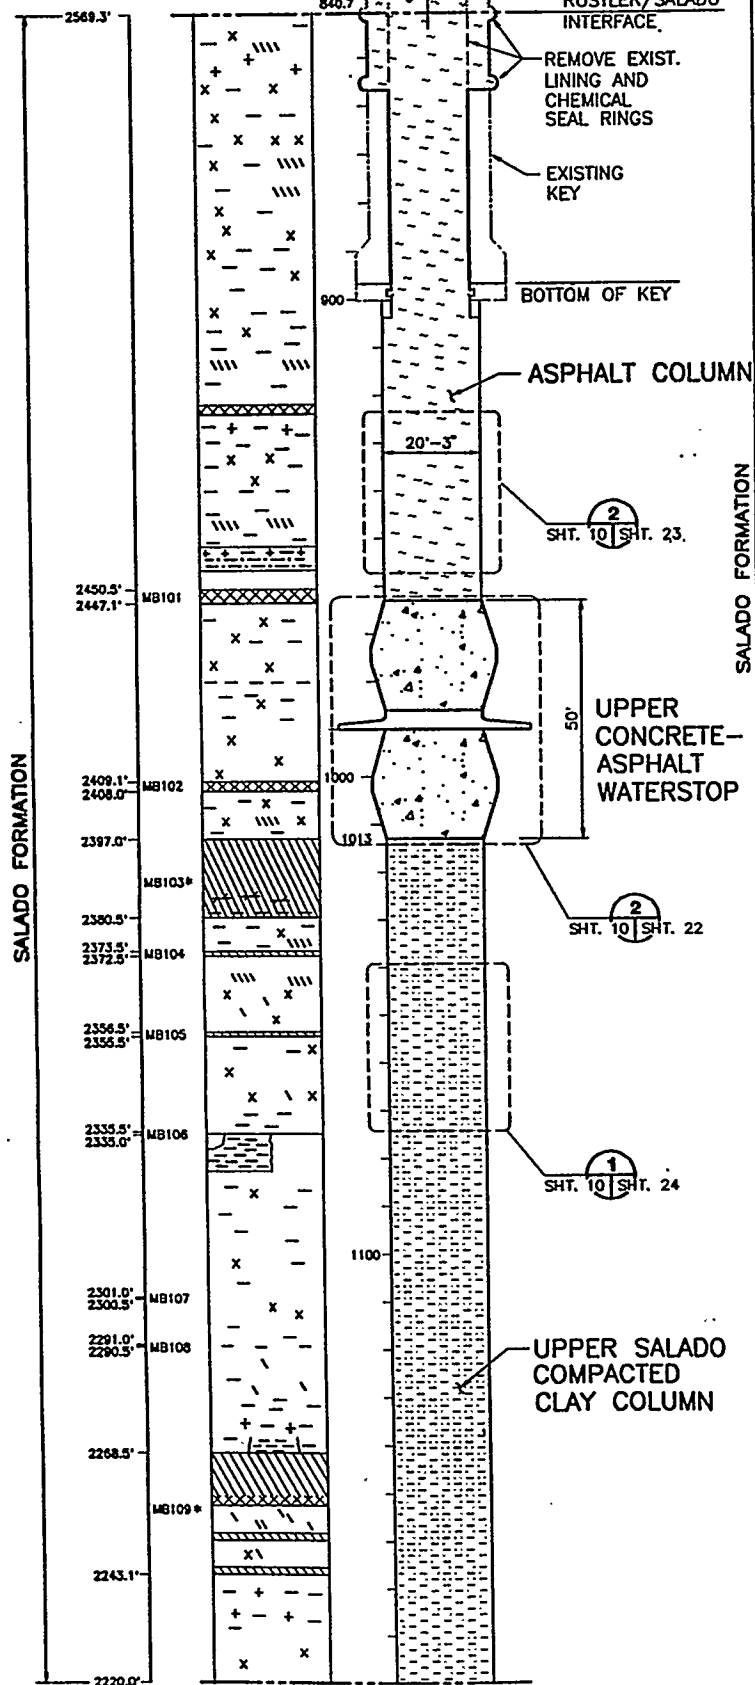



ENRY

E-14


NOTES:

1. SEE SHT. 1 FOR GENERAL NOTES, LEGEND AND ABBREVIATIONS.




A. W. Dennis
8-2-96

SCALE IN FEET

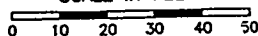



0	8/2/96	ISSUED FOR RECORDS PACKAGE	BY	CK.	APP.
REV.	DATE	DESCRIPTION	BY	CK.	APP.
SANDIA NATIONAL LABORATORIES					
WIPP A/E SUPPORT			CONTRACT NO: AG-4909		
WIPP SHAFT SEALING SYSTEM			NAME	DATE	
AIR INTAKE SHAFT SHAFT STATION MONOLITH			BY	8/2/96	
			CK.	SAP 8/2/96	
			APP.	8/2/96	
			APP.	8/2/96	
			APP.	8/2/96	
PARSONS BRINCKERHOFF ENERGY SERVICES, INC		SCALE:	SIZE B	SNL DWG. NO. SNL-007	SHEET NO. 11 OF 28

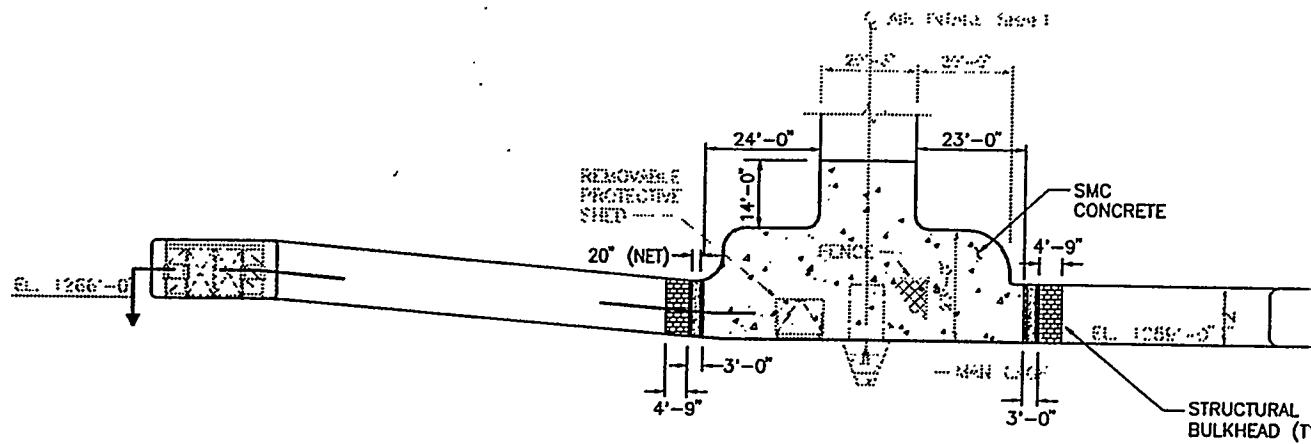

DETAIL

1
SHT. 10 | SHT. 11

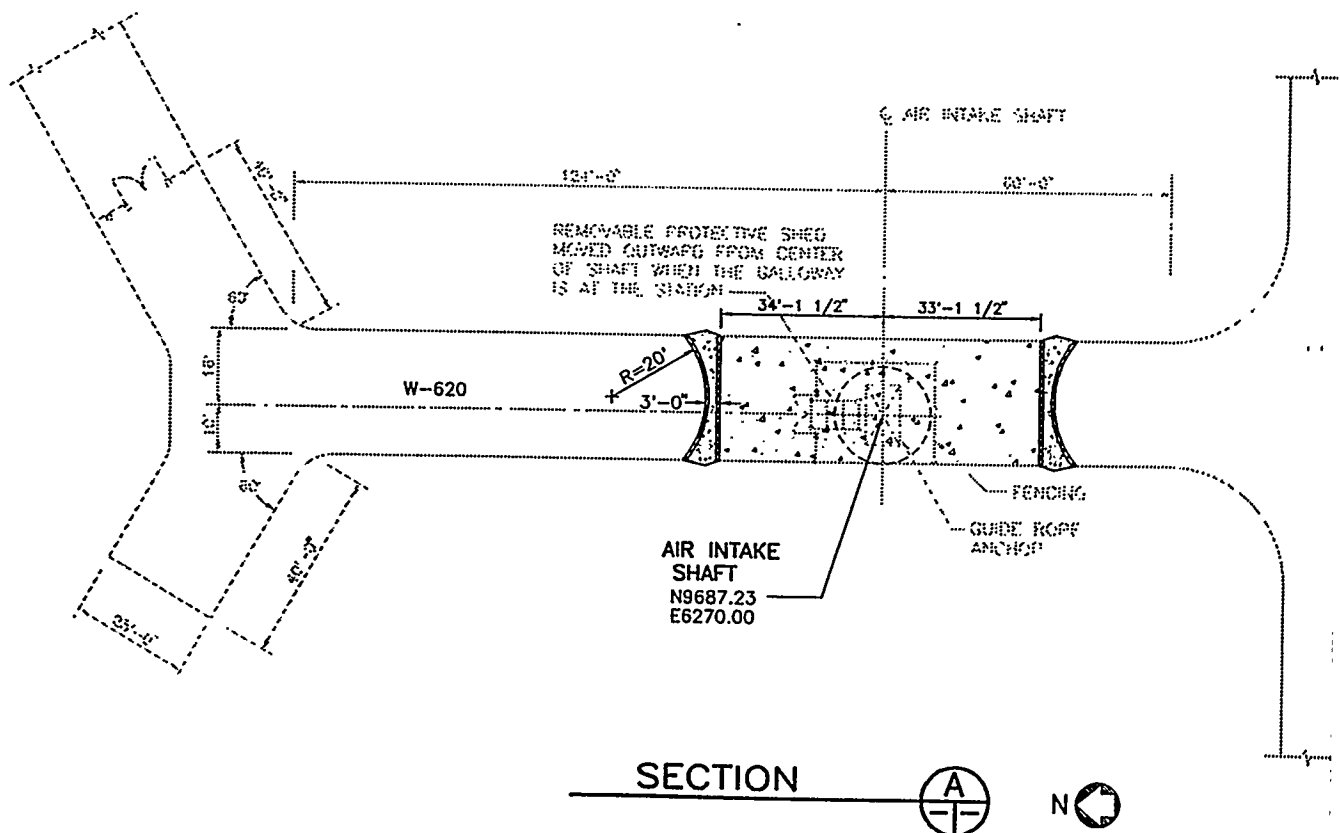

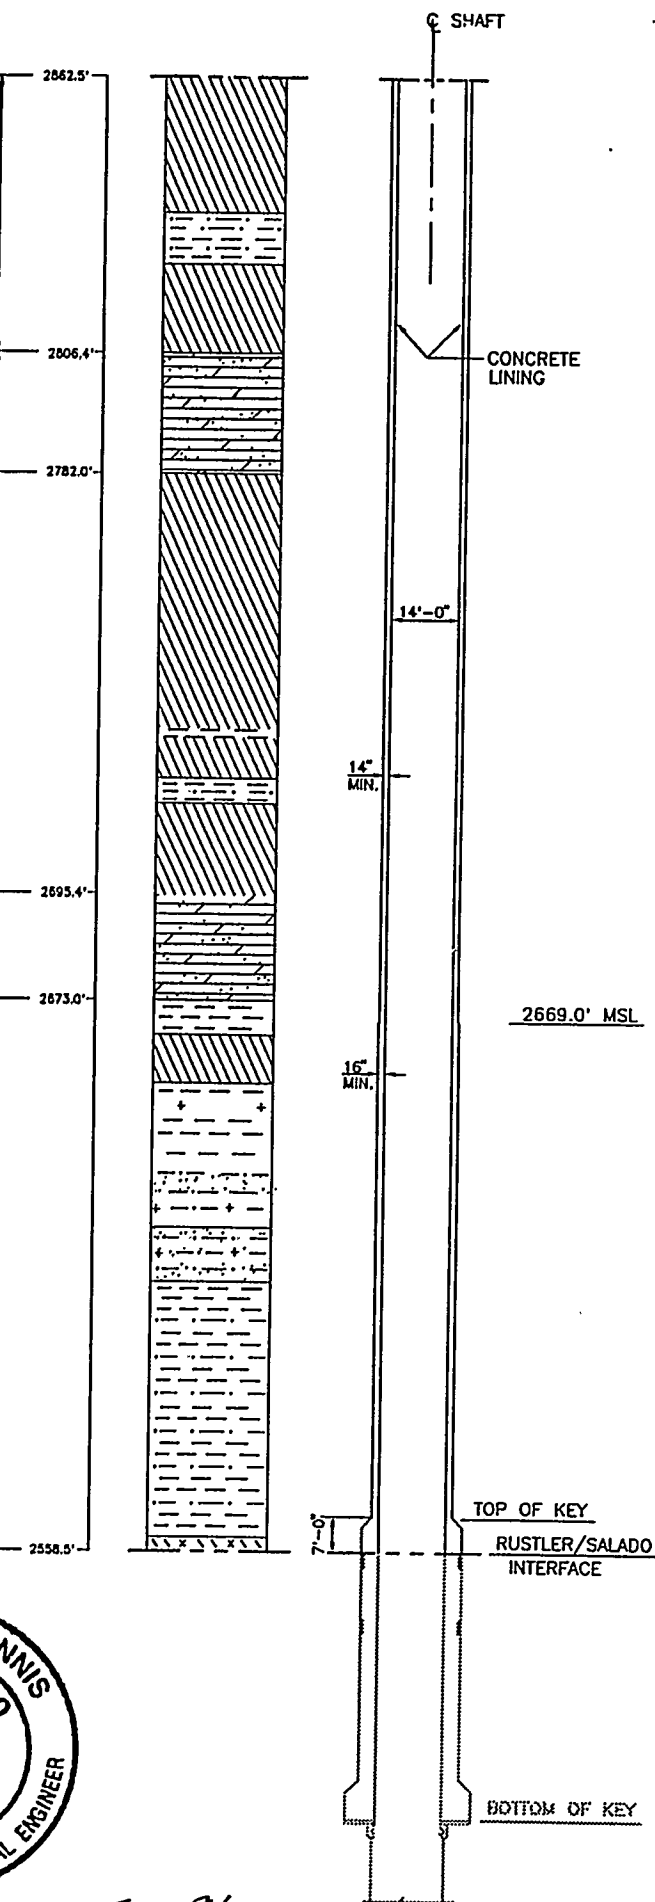

LITHOLOGY:

PRIMARY ROCK/SEDIMENT TYPES

	MUDSTONE/CLAYSTONE
	CLAYSTONE BED
	SILTSTONE
	SANDSTONE
	ANHYDRITE/GYPSUM
	DOLOMITE
	HALITE
	POLYHALITE
	CALICHE

SECONDARY CONSTITUENTS

	ARGILLACEOUS
	SILTY
	SANDY
	SULFATIC
	DOLOMITIC
	CALCAREOUS
	HALITIC
	POLYHALITIC

NOTE:

- THE STRATIGRAPHY AND GROUNDWATER BRINE SEEPAGE/WEEP INTERVALS ARE BASED ON THE LITHOLOGIC INFORMATION COMPILED DURING THE GEOLOGIC MAPPING OF THE EXHAUST SHAFT WALLS DOE-WIPP-86-008, "GEOTECHNICAL ACTIVITIES IN THE EXHAUST SHAFT", AND APPENDIX A OF REPORT DOE/WIPP-95-3117, "WASTE ISOLATION PILOT PLANT SEALING SYSTEM DESIGN REPORT", 1995.

ASTERISK (*) WITHIN THE RUSTLER AND SUPRA RUSTLER FORMATIONS INDICATE GROUNDWATER OBSERVED DURING SHAFT MAPPING. ASTERISK (*) WITHIN THE SALADO FORMATION INDICATES A POTENTIAL BRINE SEEPAGE/WEEP INTERVAL. THESE POTENTIAL BRINE SEEPAGE/WEEP INTERVALS ARE BASED ON OBSERVED INTERVALS OF BRINE SEEPAGE /WEEPS IN THE AIR INTAKE SHAFT THAT HAVE BEEN PROJECTED TO THE EXHAUST SHAFT. THE MAPPING OF THE EXHAUST SHAFT (HOLT & POWERS, 1986/DOE-WIPP 86-008) DID NOT INDICATE OBSERVED SEEPAGE INTERVALS WITHIN THE SALADO FORMATION.

2. REFERENCE AS-BUILT DRAWINGS FROM WID:

EXHAUST SHAFT 351, SHAFT LINING AND KEY SECTION AND DETAILS	35-R-002-01D
EXHAUST SHAFT 351, GENERAL ARRANGEMENT, PLANS AND SECTIONS	35-R-004-01D
EXHAUST SHAFT WINCH AND COLLAR LAYOUT - SHOWS PERMANENT COLLAR STRUCTURE	OGL-S-020-1FB
EXHAUST SHAFT, SHAFT DEVELOPMENT, PLAN, SECTIONS AND DETAIL	WTSD 390D064 (1 of 2)

0				8/2/96	ISSUED FOR RECORDS PACKAGE	BY	CK.	APP.
REV.	DATE	DESCRIPTION	BY	CK.	APP.			
SANDIA NATIONAL LABORATORIES WIPP A/E SUPPORT WIPP SHAFT SEALING SYSTEM NEAR-SURFACE/RUSTLER FORMATIONS EXHAUST SHAFT STRATIGRAPHY & AS-BUILT ELEMENTS								
CONTRACT NO: AG-4909								
NAME		DATE						
BY		8/2/96						
CK.		8/2/96						
APP.		8/2/96						
APP.		8/2/96						
APP.		8/2/96						
PARSONS BRINCKERHOFF ENERGY SERVICES, INC		SCALE: SIZE B		SNL DWG. NO. SNL-007		SHEET NO. 12 OF 28		


ANNIS
ENGINEER

8.2-96


E-15

STRATIGRAPHY


(SEE NOTE 1)

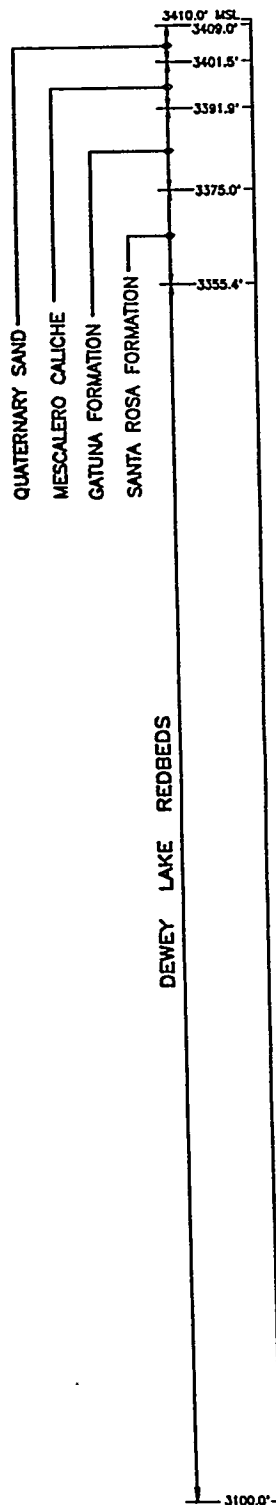

SHAFT

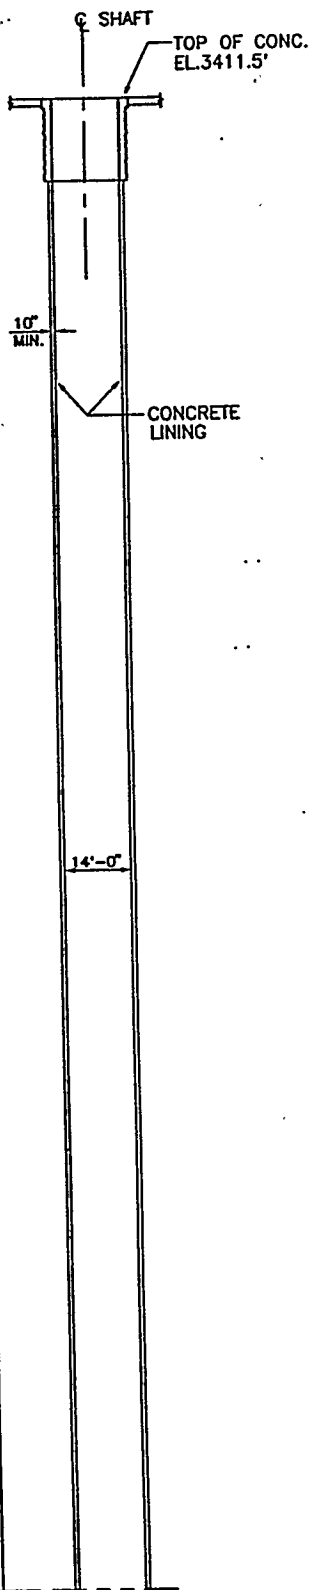

DEWEY LAKE REDBEDS



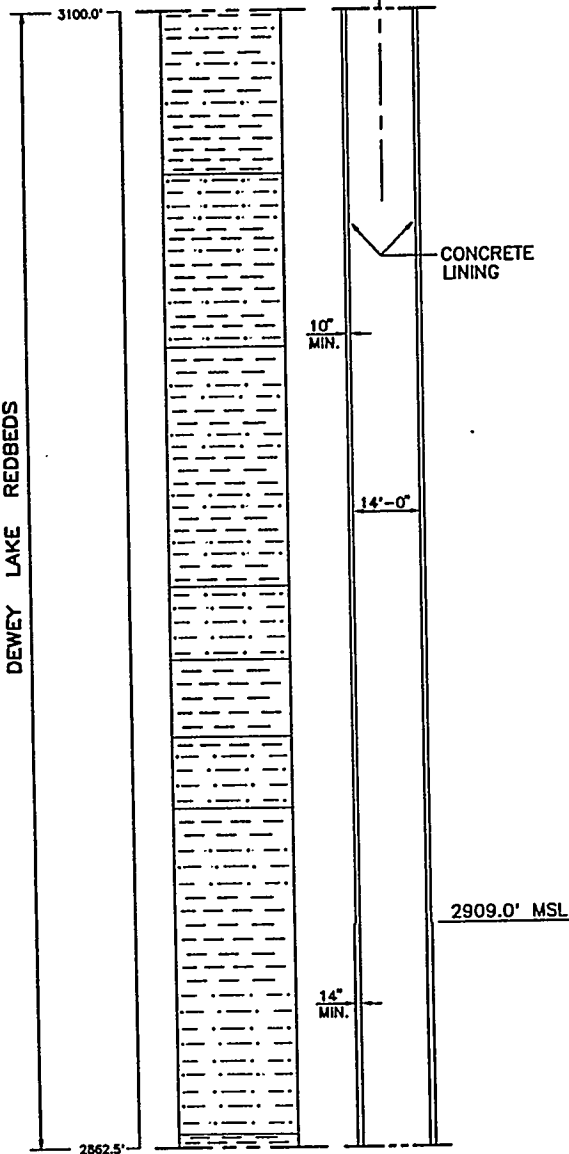


RUSTLER FORMATION

QUATERNARY SAND
MAGENTA *
TAMARICK *
CULEBRA *
UNPAVED *
FIFTY-NINER *
DEWEY LAKE REDBEDS




Albert W. D.

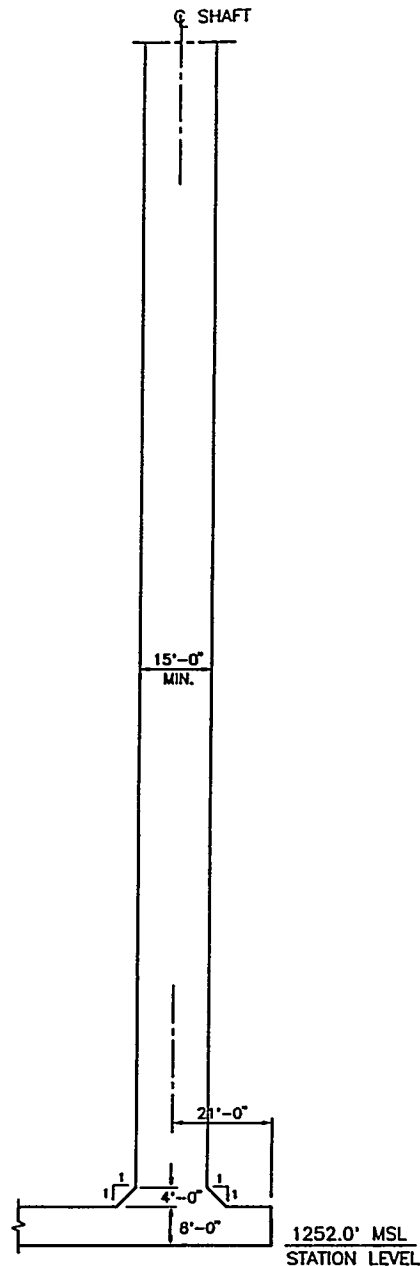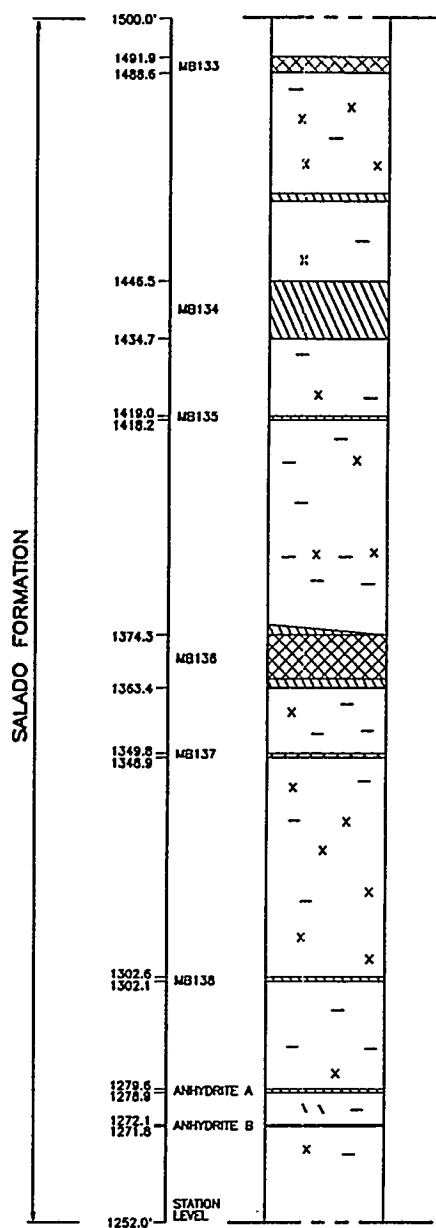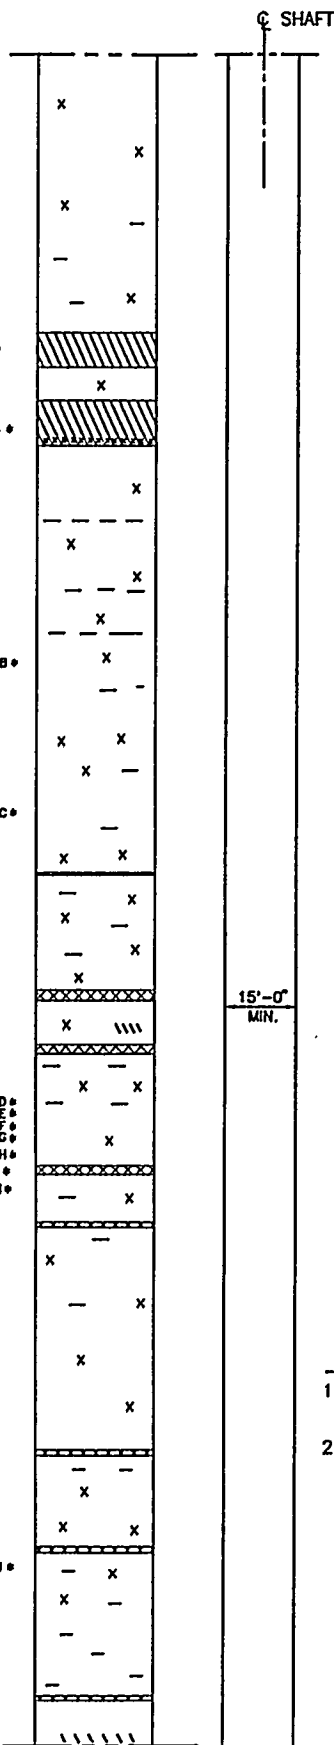

NOTES:

1. SEE SHT. 1 FOR GENERAL NOTES AND ABBREVIATIONS
2. SEE SHT. 12 FOR LITHOLOGY AND NOTES.

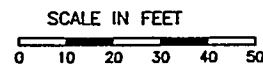


A. W. Dennis
8-2-96


0	8/2/96	ISSUED FOR RECORDS PACKAGE	BY	CK.	APP.
REV.	DATE	DESCRIPTION	BY	CK.	APP.
SANDIA NATIONAL LABORATORIES					
WIPP A/E SUPPORT			CONTRACT NO: AC-4909		
WIPP SHAFT SEALING SYSTEM			NAME	DATE	
SALADO FORMATION			BY	8/2/96	
EXHAUST SHAFT			CK.	8/2/96	
STRATIGRAPHY &			APP.	8/2/96	
AS-BUILT ELEMENTS			APP.	8/2/96	
PARSONS BRINCKERHOFF ENERGY SERVICES, INC	SCALE:	SIZE B	SNL DWG. NO. SNL-007	SHEET NO. 13 OF 28	

STRATIGRAPHY



(SEE NOTE 2)

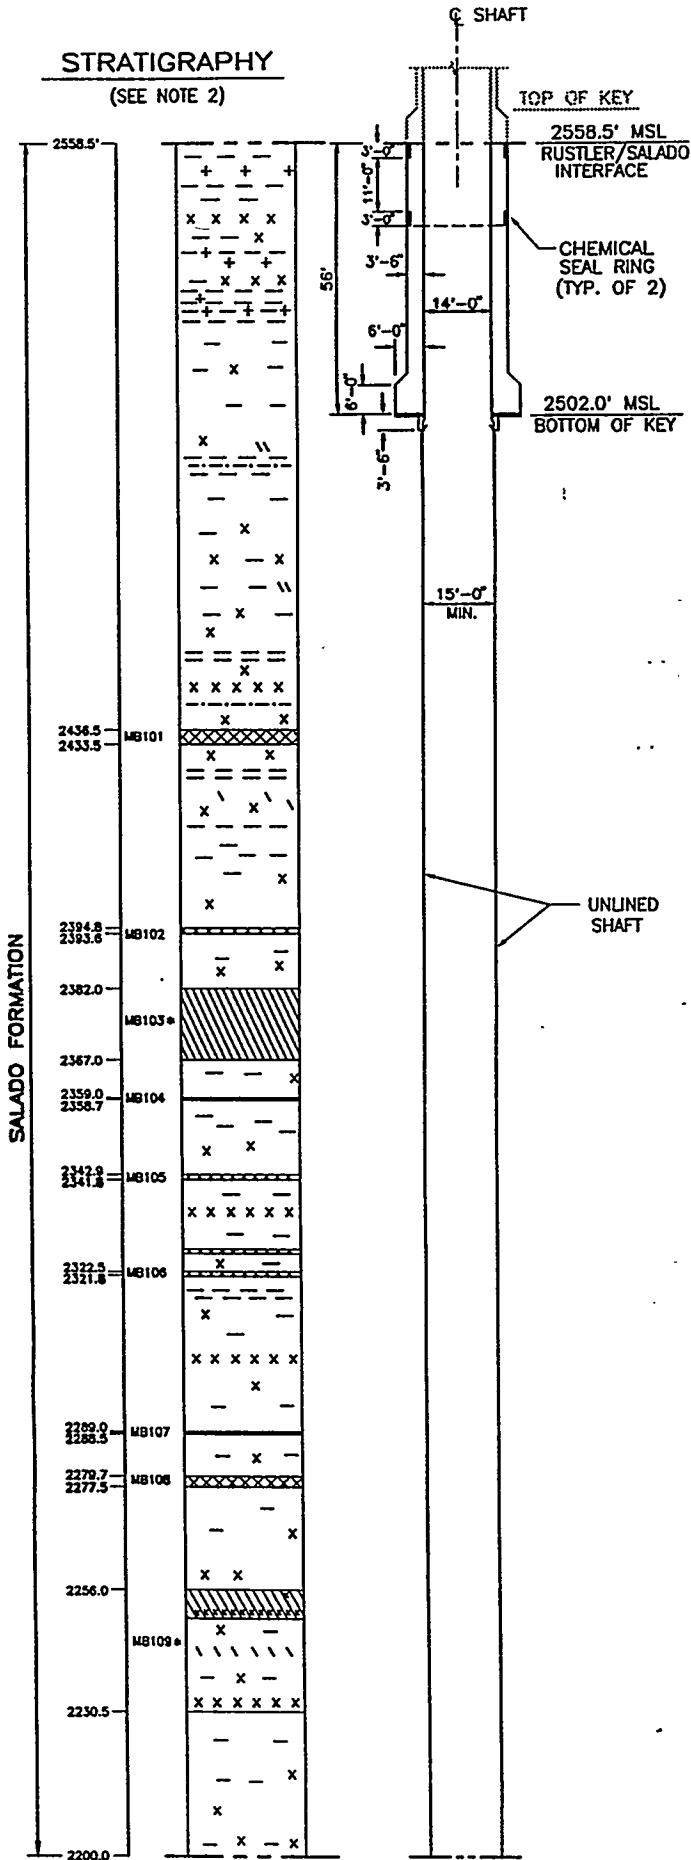

SALADO FORMATION

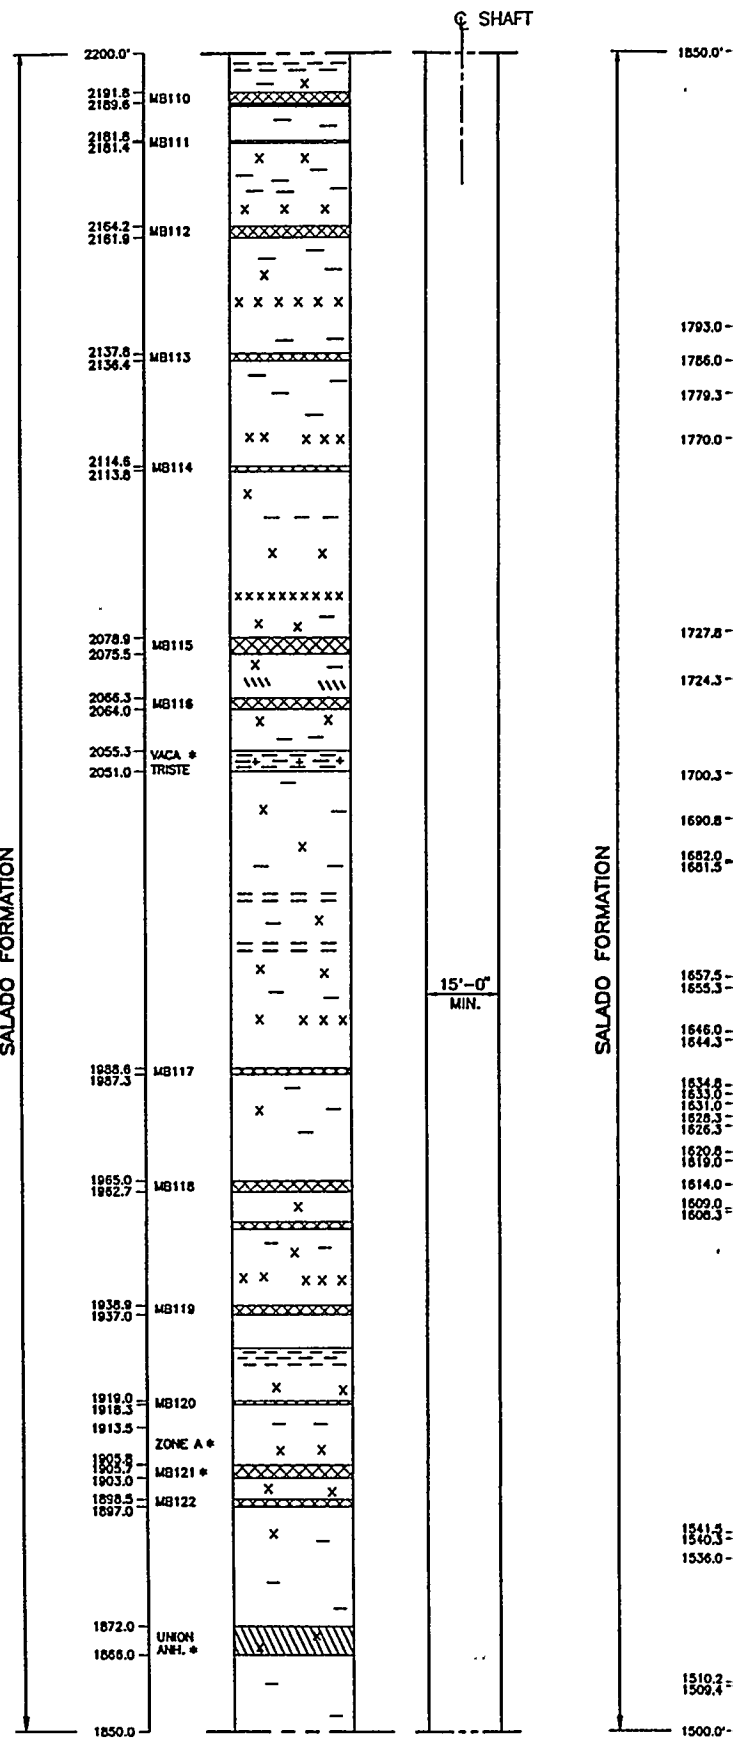

SALADO FORMATION

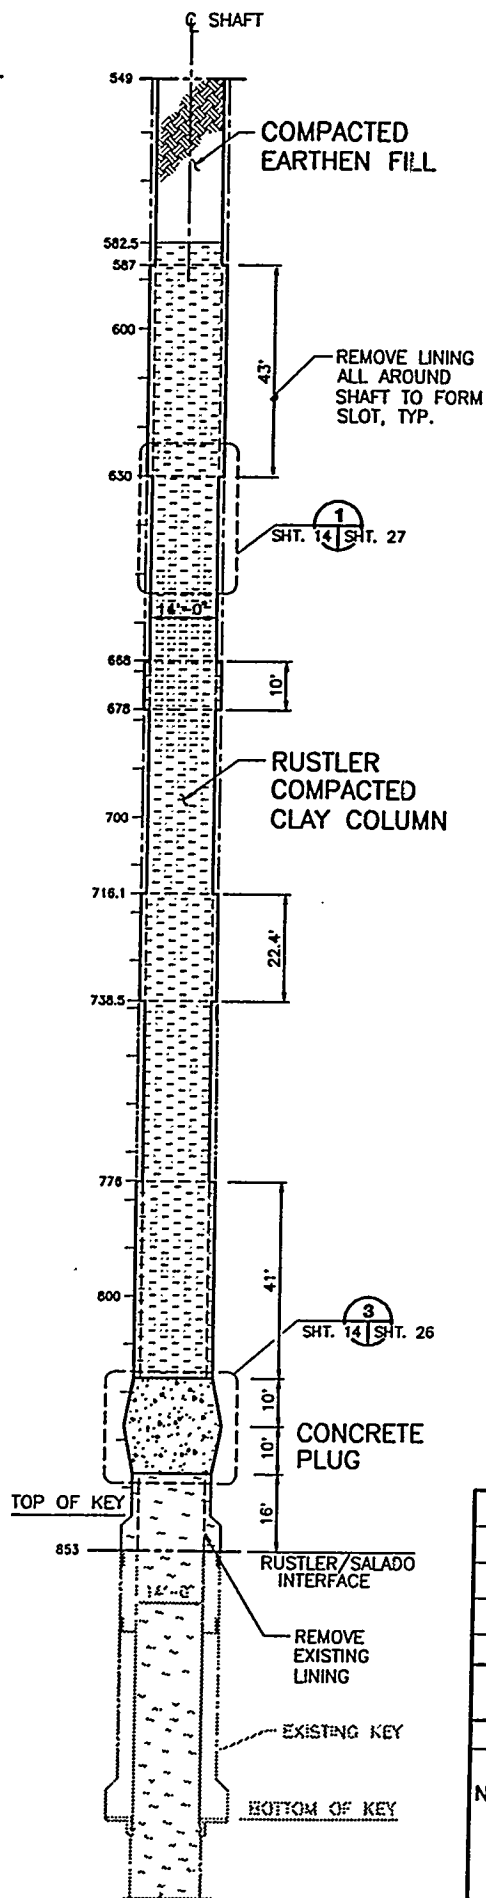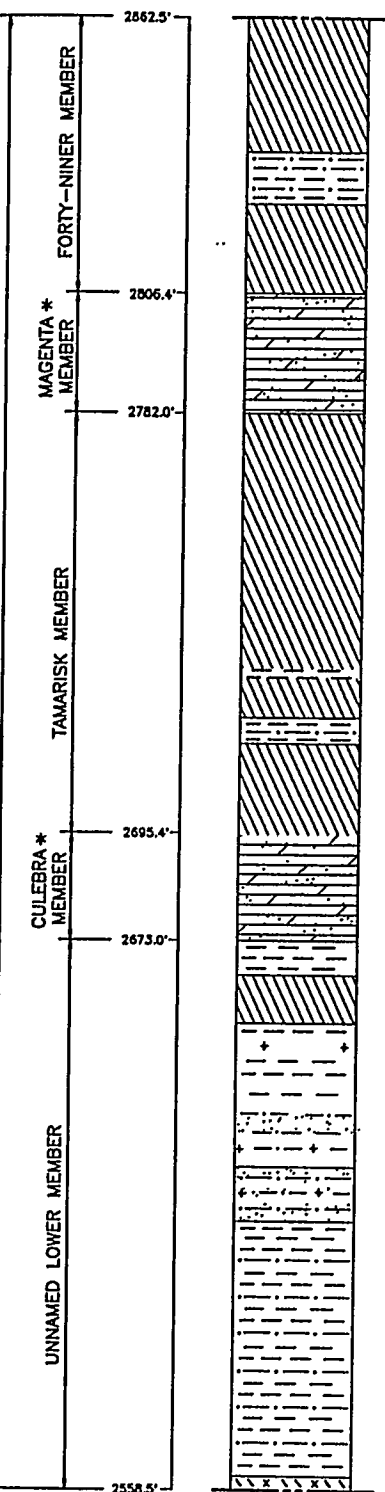


NOTES:

1. SEE SHT. 1 FOR GENERAL NOTE, LEGEND AND ABBREVIATIONS
2. SEE SHT. 12 FOR LITHOLOGY AND NOTES.
3. DEPTHS SHOWN ARE DISTANCES BELOW THE TOP OF CONCRETE, LOCATED AT EL. 3411.5' ABOVE MSL USGS 1927 NORTH AMERICAN DATUM.



A.W. Dennis 8-2-86

 SCALE IN FEET






0	8/2/86	ISSUED FOR RECORDS PACKAGE	BY	CK	APP
REV.	DATE	DESCRIPTION	BY	CK	APP
SANDIA NATIONAL LABORATORIES WIPP A/E SUPPORT WIPP SHAFT SEALING SYSTEM NEAR-SURFACE/RUSTLER FORMATIONS EXHAUST SHAFT STRATIGRAPHY & SEALING SUBSYSTEM PROFILE					
PARSONS BRINCKERHOFF ENERGY SERVICES, INC			SCALE: SIZE B	SNL DWG. NO. SNL-007	SHEET NO. 14 OF 28

STRATIGRAPHY

(SEE NOTE 2)

SHAFT

DEPTH
(SEE NOTE 3)

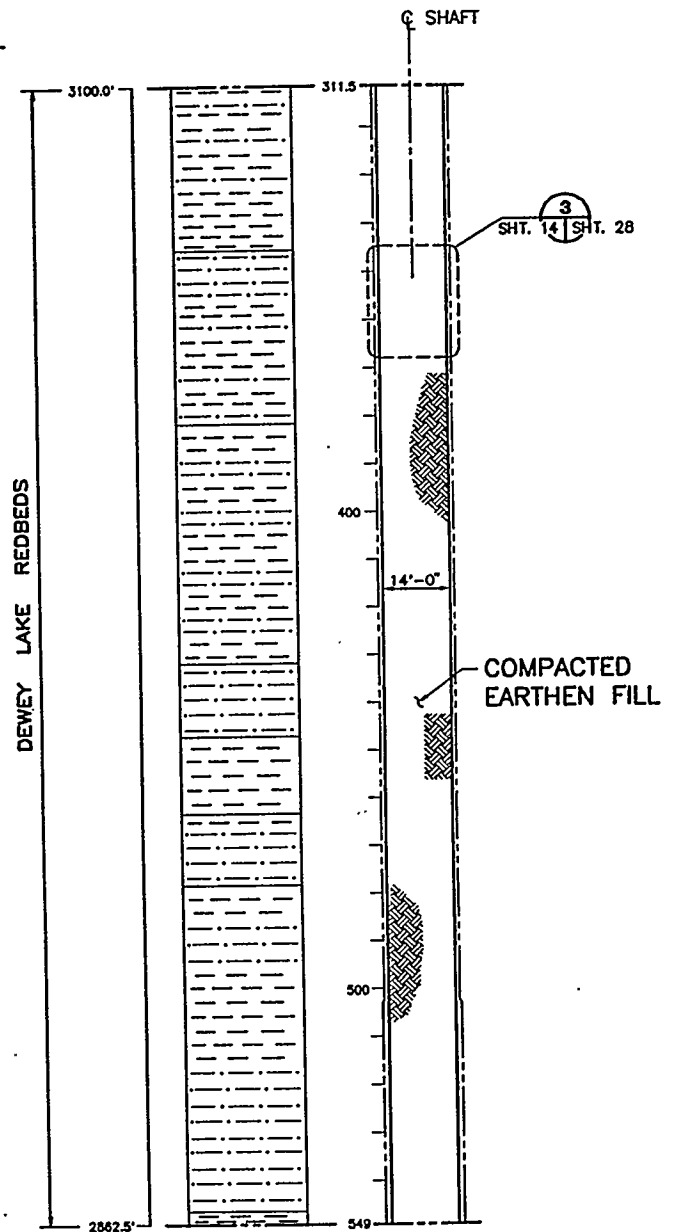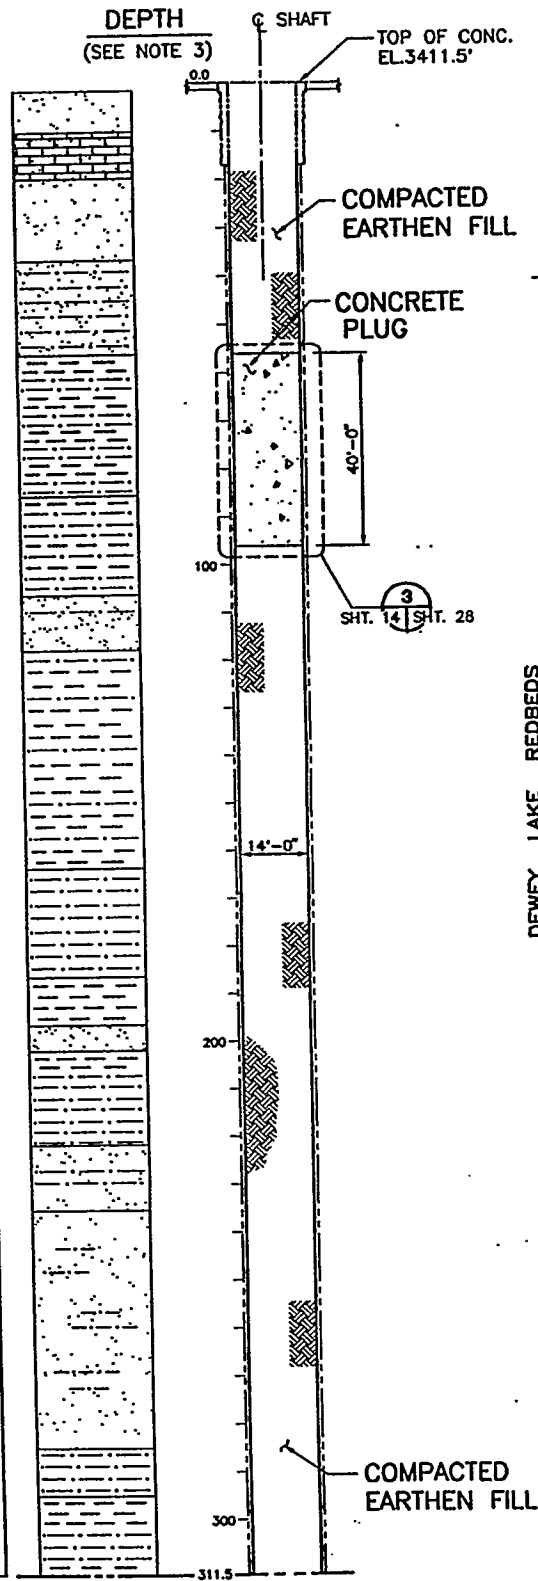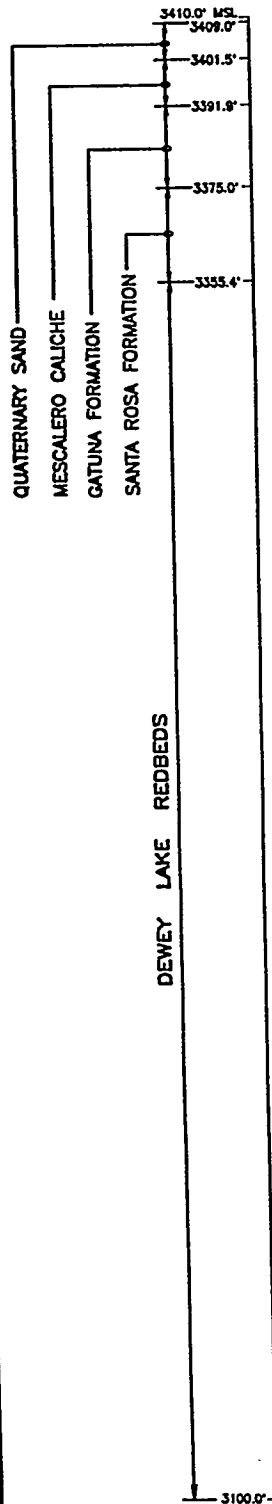




1. SEE SHT. 1 FOR GENERAL NOTES, LEGEND AND ABBREVIATIONS.
2. SEE SHT. 12 FOR LITHOLOGY AND NOTES.
3. SEE NOTE 3 OF SHT. 14.



A. M. Dennis
8-2-96

SCALE IN FEET

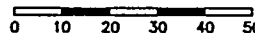


0	8/2/96	ISSUED FOR RECORDS PACKAGE					<i>R. S. L.</i>		
REV.	DATE	DESCRIPTION					BY	CK.	APP.
SANDIA NATIONAL LABORATORIES									
WIPP A/E SUPPORT WIPP SHAFT SEALING SYSTEM SALADO FORMATION EXHAUST SHAFT STRATIGRAPHY & SEALING SUBSYSTEM PROFILE							CONTRACT NO: AG-4909		
							NAME	DATE	
							BY	<i>[Signature]</i> 8/6/96	
							CK.	<i>SAP</i> 8/6/96	
							APP.	<i>M.S.L.</i> 8/6/96	
							APP.	<i>C. Mena</i> 9/2/96	
							APP.	<i>[Signature]</i> 7/2/96	
PARSONS BRINCKERHOFF ENERGY SERVICES, INC			SCALE:	SIZE	SNL DWG. NO. SNL--007		SHEET NO. 15 OF 28		


STRATIGRAPHY

(SEE NOTE 2)

DEPTH
(SEE NOTE 3)

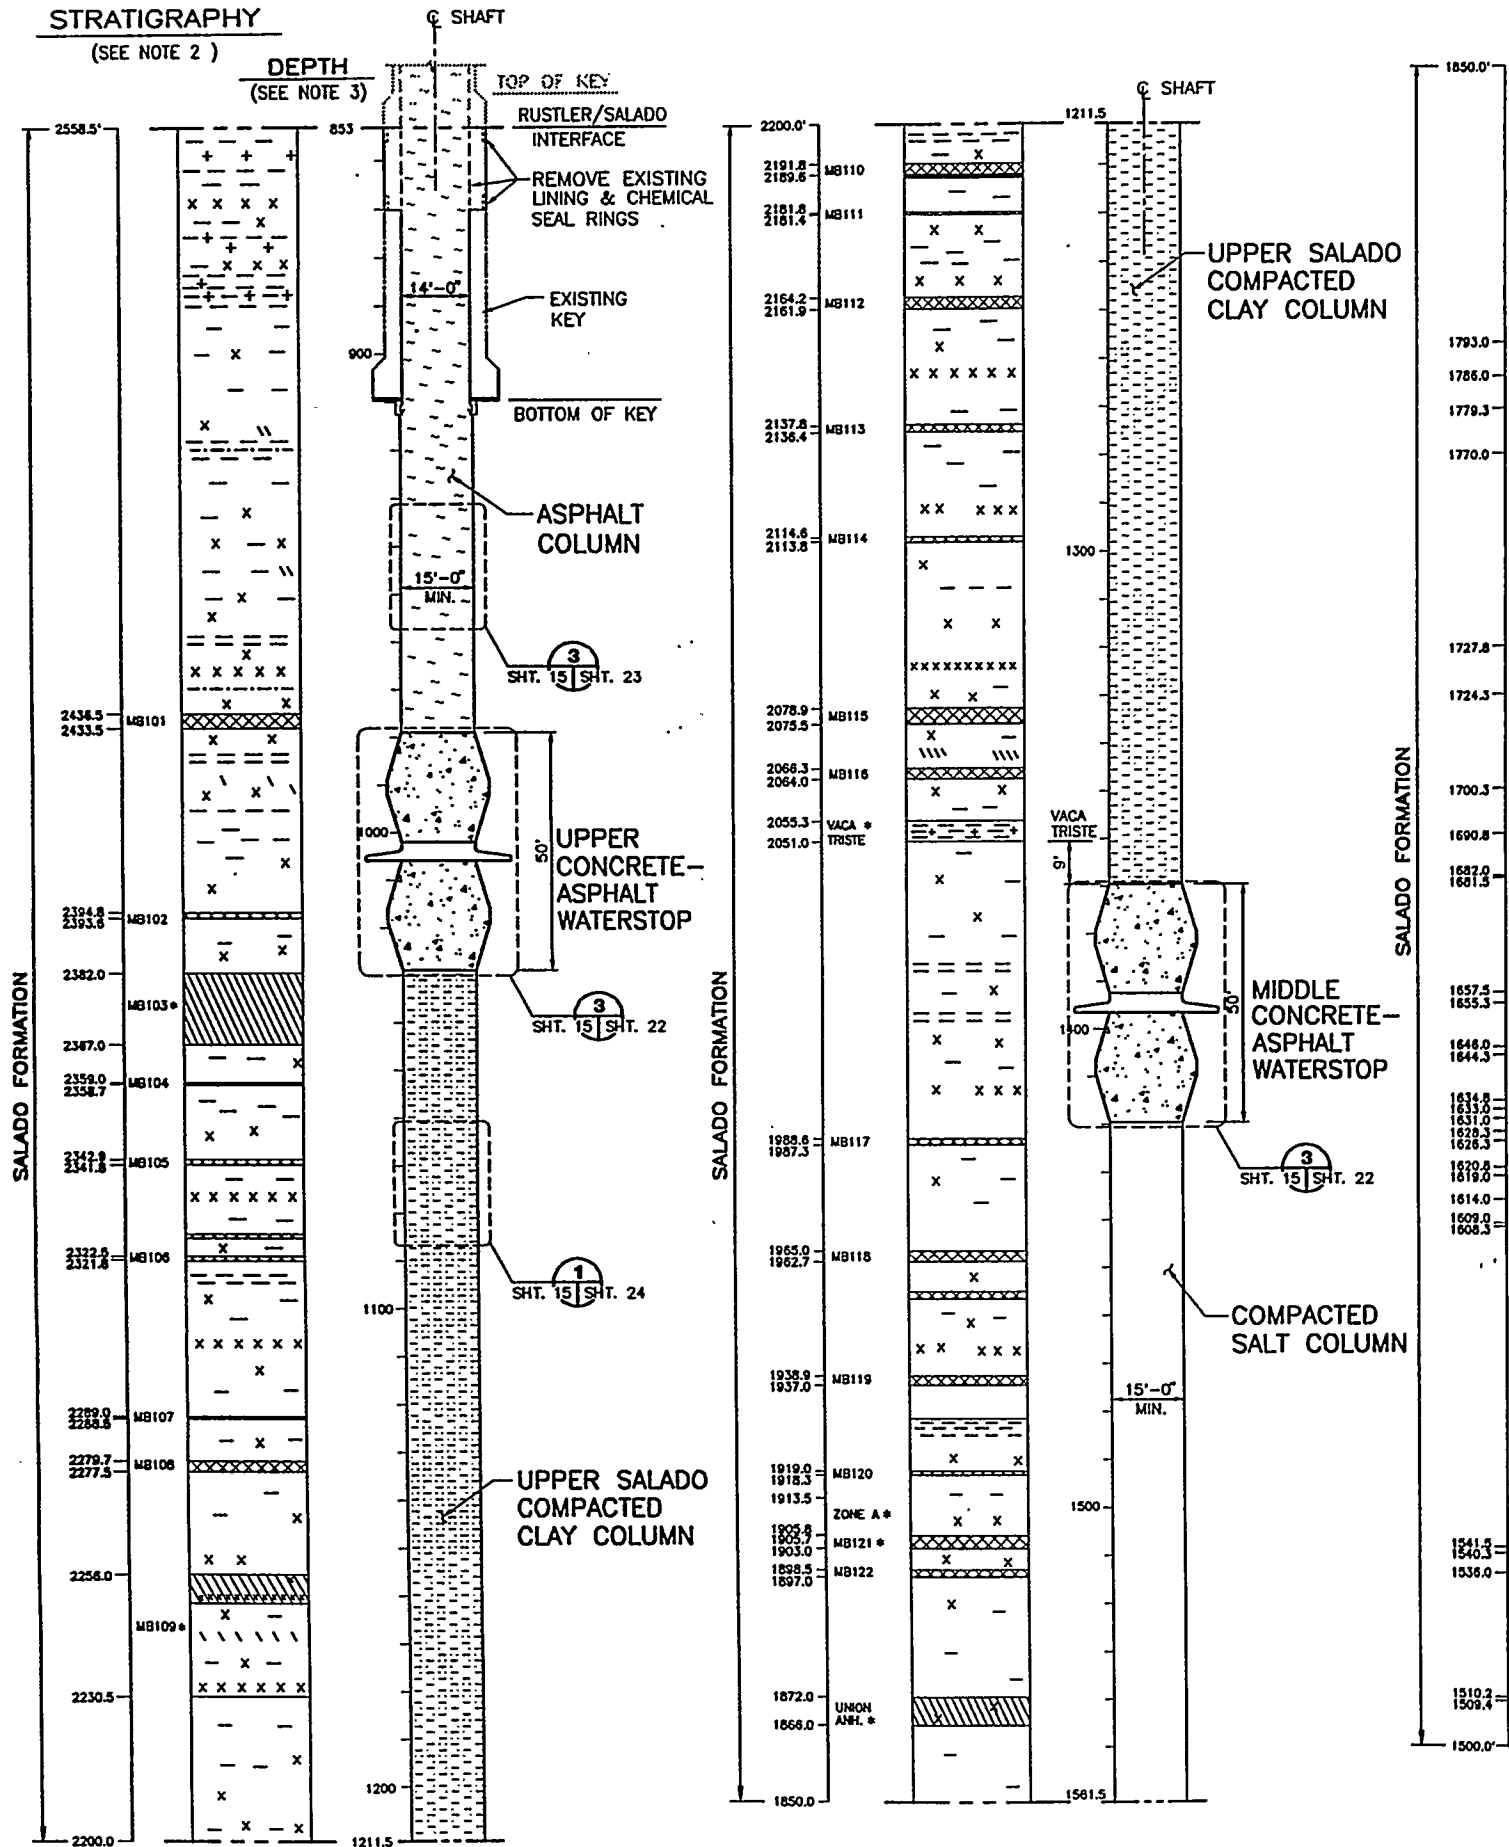

EXHAUST SHAFT
N9287.23
E7370.39

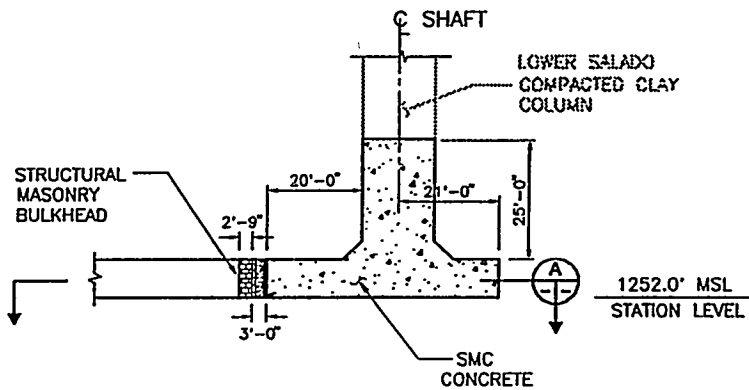

DETAIL

SHT. 15 | 1 | SHT. 16

NOTES:

1. SEE SHT. 1 FOR GENERAL NOTES, LEGEND AND ABBREVIATIONS.




A. W. Dennis 8-2-96

SCALE IN FEET

0 10 20 30 40 50

0	8/2/96	ISSUED FOR RECORDS PACKAGE	BY	CK.	APP.
REV.	DATE	DESCRIPTION	BY	CK.	APP.
SANDIA NATIONAL LABORATORIES					
WIPP A/E SUPPORT			CONTRACT NO: AG-4909		
WIPP SHAFT SEALING SYSTEM			NAME	DATE	
EXHAUST SHAFT SHAFT STATION MONOLITH			BY	8/2/96	
			CK.	SAP 8/2/96	
			APP.	MST 8/2/96	
			APP.	EDM 8/2/96	
			APP.	MST 8/2/96	
PARSONS BRINCKERHOFF ENERGY SERVICES, INC		SCALE:	SIZE B	SNL DWG. NO. SNL-007	SHEET NO. 16 OF 28

E-19

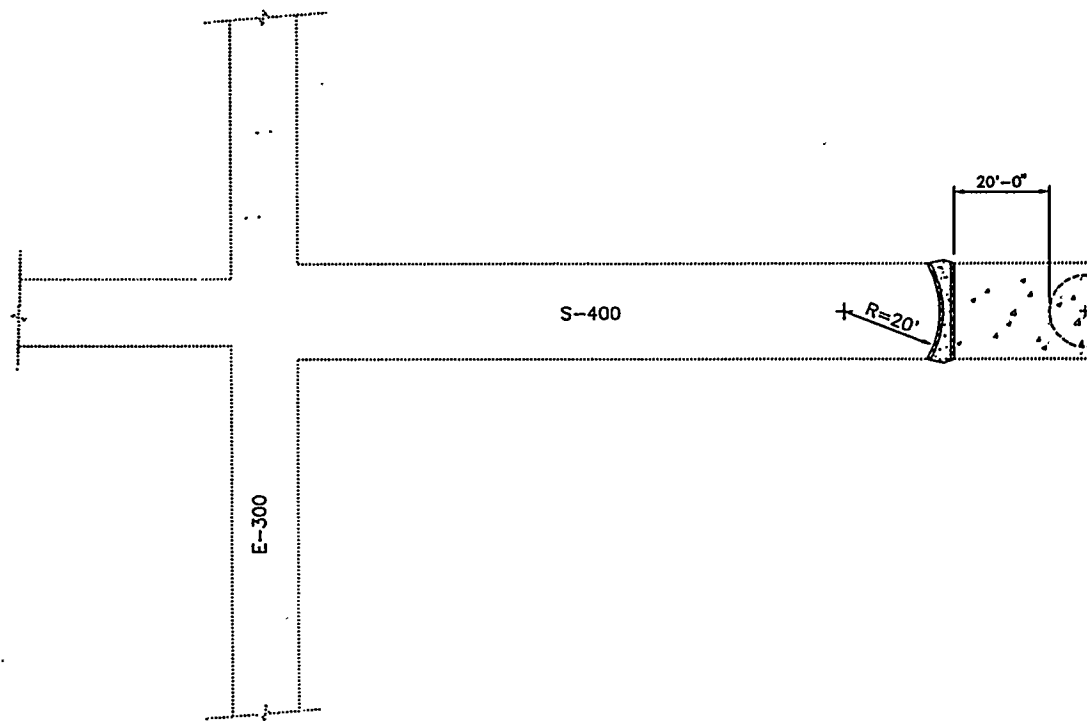

SECTION



LITHOLOGY:

PRIMARY ROCK/SEDIMENT TYPES

	MUDSTONE/CLAYSTONE
	CLAYSTONE BED
	SILTSTONE
	SANDSTONE
	ANHYDRITE/GYPSUM
	DOLOMITE
	HALITE
	POLYHALITE

SECONDARY CONSTITUENTS

	ARGILLACEOUS
	SILTY
	SANDY
	SULFATIC
	DOLOMITIC
	CALCAREOUS
	HALITIC
	POLYHALITIC

NOTES:

1. THE STRATIGRAPHY AND GROUNDWATER BRINE SEEPAGE/WEEP INTERVALS ARE BASED ON THE LITHOLOGIC INFORMATION COMPILED DURING THE GEOLOGIC MAPPING OF THE SALT HANDLING SHAFT WALLS, TME 3178; "GEOTECHNICAL ACTIVITIES IN THE EXPLORATORY SHAFT-SELECTION OF THE FACILITY INTERVAL"; AND APPENDIX A OF REPORT DOE/WIPP-95-3117, "WASTE ISOLATION PILOT PLANT SEALING SYSTEM DESIGN REPORT", 1995.


ASTERISK (*) WITHIN THE RUSTLER AND SUPRA RUSTLER FORMATIONS AND THE RUSTLER/SALADO FORMATION CONTACT INDICATES GROUNDWATER OBSERVED PRIOR TO SHAFT LINING INSTALLATION. ASTERISK (*) WITHIN THE SALADO FORMATION INDICATES A POTENTIAL BRINE SEEPAGE/WEEP INTERVAL. THESE POTENTIAL BRINE SEEPAGE/WEEP INTERVALS, LOCATED ABOVE THE SHAFT STATION LEVEL, ARE BASED ON OBSERVED INTERVALS OF BRINE SEEPAGE/WEEPS IN THE AIR INTAKE SHAFT THAT HAVE BEEN PROJECTED TO THE SALT HANDLING SHAFT. THE MAPPING OF THE SALT HANDLING SHAFT (JAROLMEK ET AL., 1983/TME-3178) DID NOT INDICATE OBSERVED SEEPAGE INTERVALS WITHIN THE SALADO FORMATION.

2. REFERENCE AS-BUILT DRAWINGS FROM WID:

EXPLORATORY SHAFT KEY SHAFT STATION LOCATION, SECTIONS	37-R-010
EXPLORATORY SHAFT KEY, SECTIONS AND DETAILS	37-R-012
EXPLORATORY SHAFT STATION DEVELOPMENT - EXPERIMENTAL LEVEL PLAN AND SECTIONS	37-R-019
UNDERGROUND BASE PLAN E-0 DRIFT FROM N-9900 TO N-9580	51-W-126-W5
WIPP EXHAUST SHAFT 120" I.D. CASING x 834'	FS-M3259-01
WIPP PROJECT 120" I.D. CASING LINER HOLE COMPLEX	FS M3259-02


3. HISTORICAL NOTE: SINCE ITS CONSTRUCTION, THE SALT HANDLING SHAFT HAS BEEN REFERRED TO AS THE EXHAUST SHAFT, THE EXPLORATORY SHAFT, THE CONSTRUCTION AND SALT HANDLING SHAFT, AND THE SALT HANDLING SHAFT.




4. THICKNESS OF STEEL LINING VARIES, LINING TYPE AND LENGTH ARE BASED ON FENIX AND SCISSON AS-BUILT DWGS. M3259-02, REV. 0, DATED 11/30/79, WIPP PROJECT 120" I.D. CASING LINER HOLE COMPLEX, AND M3259-01, REV. 1, DATED 10/13/80, WIPP EXHAUST SHAFT 120" I.D. CASING x 834'.

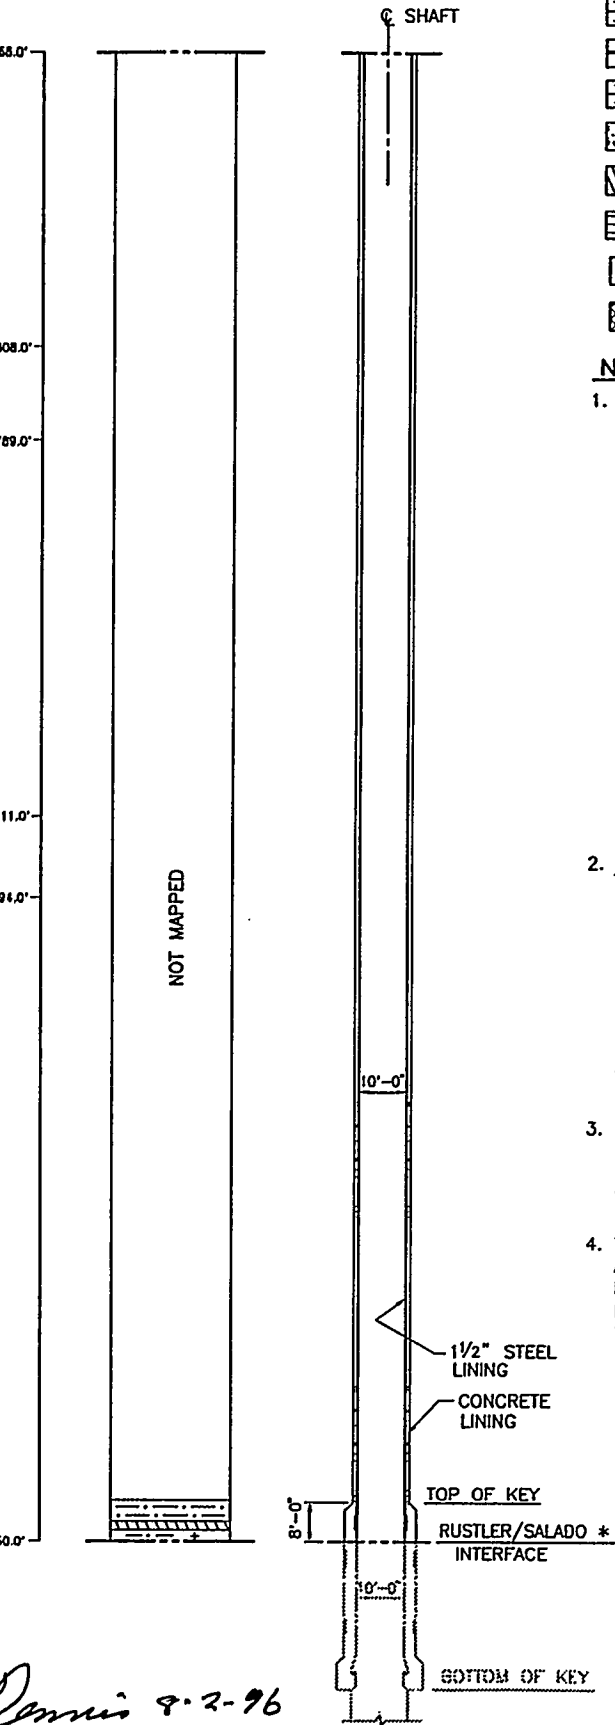

SCALE IN FEET
0 10 20 30 40 50

0	8/2/96	ISSUED FOR RECORDS PACKAGE	BY	CK.	APP.												
REV.	DATE	DESCRIPTION	BY	CK.	APP.												
SANDIA NATIONAL LABORATORIES																	
WIPP A/E SUPPORT WIPP SHAFT SEALING SYSTEM NEAR-SURFACE/RUSTLER FORMATIONS SALT HANDLING SHAFT STRATIGRAPHY & AS-BUILT ELEMENTS			CONTRACT NO: AG-4909 <table border="1"> <tr> <td>NAME</td> <td>DATE</td> </tr> <tr> <td>BY: <i>02/08/96</i></td> <td></td> </tr> <tr> <td>CK: <i>SAP 8/2/96</i></td> <td></td> </tr> <tr> <td>APP: <i>AS 8/2/96</i></td> <td></td> </tr> <tr> <td>APP: <i>CDM 8/2/96</i></td> <td></td> </tr> <tr> <td>APP: <i>02/08/96</i></td> <td></td> </tr> </table>			NAME	DATE	BY: <i>02/08/96</i>		CK: <i>SAP 8/2/96</i>		APP: <i>AS 8/2/96</i>		APP: <i>CDM 8/2/96</i>		APP: <i>02/08/96</i>	
NAME	DATE																
BY: <i>02/08/96</i>																	
CK: <i>SAP 8/2/96</i>																	
APP: <i>AS 8/2/96</i>																	
APP: <i>CDM 8/2/96</i>																	
APP: <i>02/08/96</i>																	
PARSONS BRINCKERHOFF ENERGY SERVICES, INC	SCALE:	SIZE 8	SNL DWG. NO. SNL-007	SHEET NO. 17 OF 28													

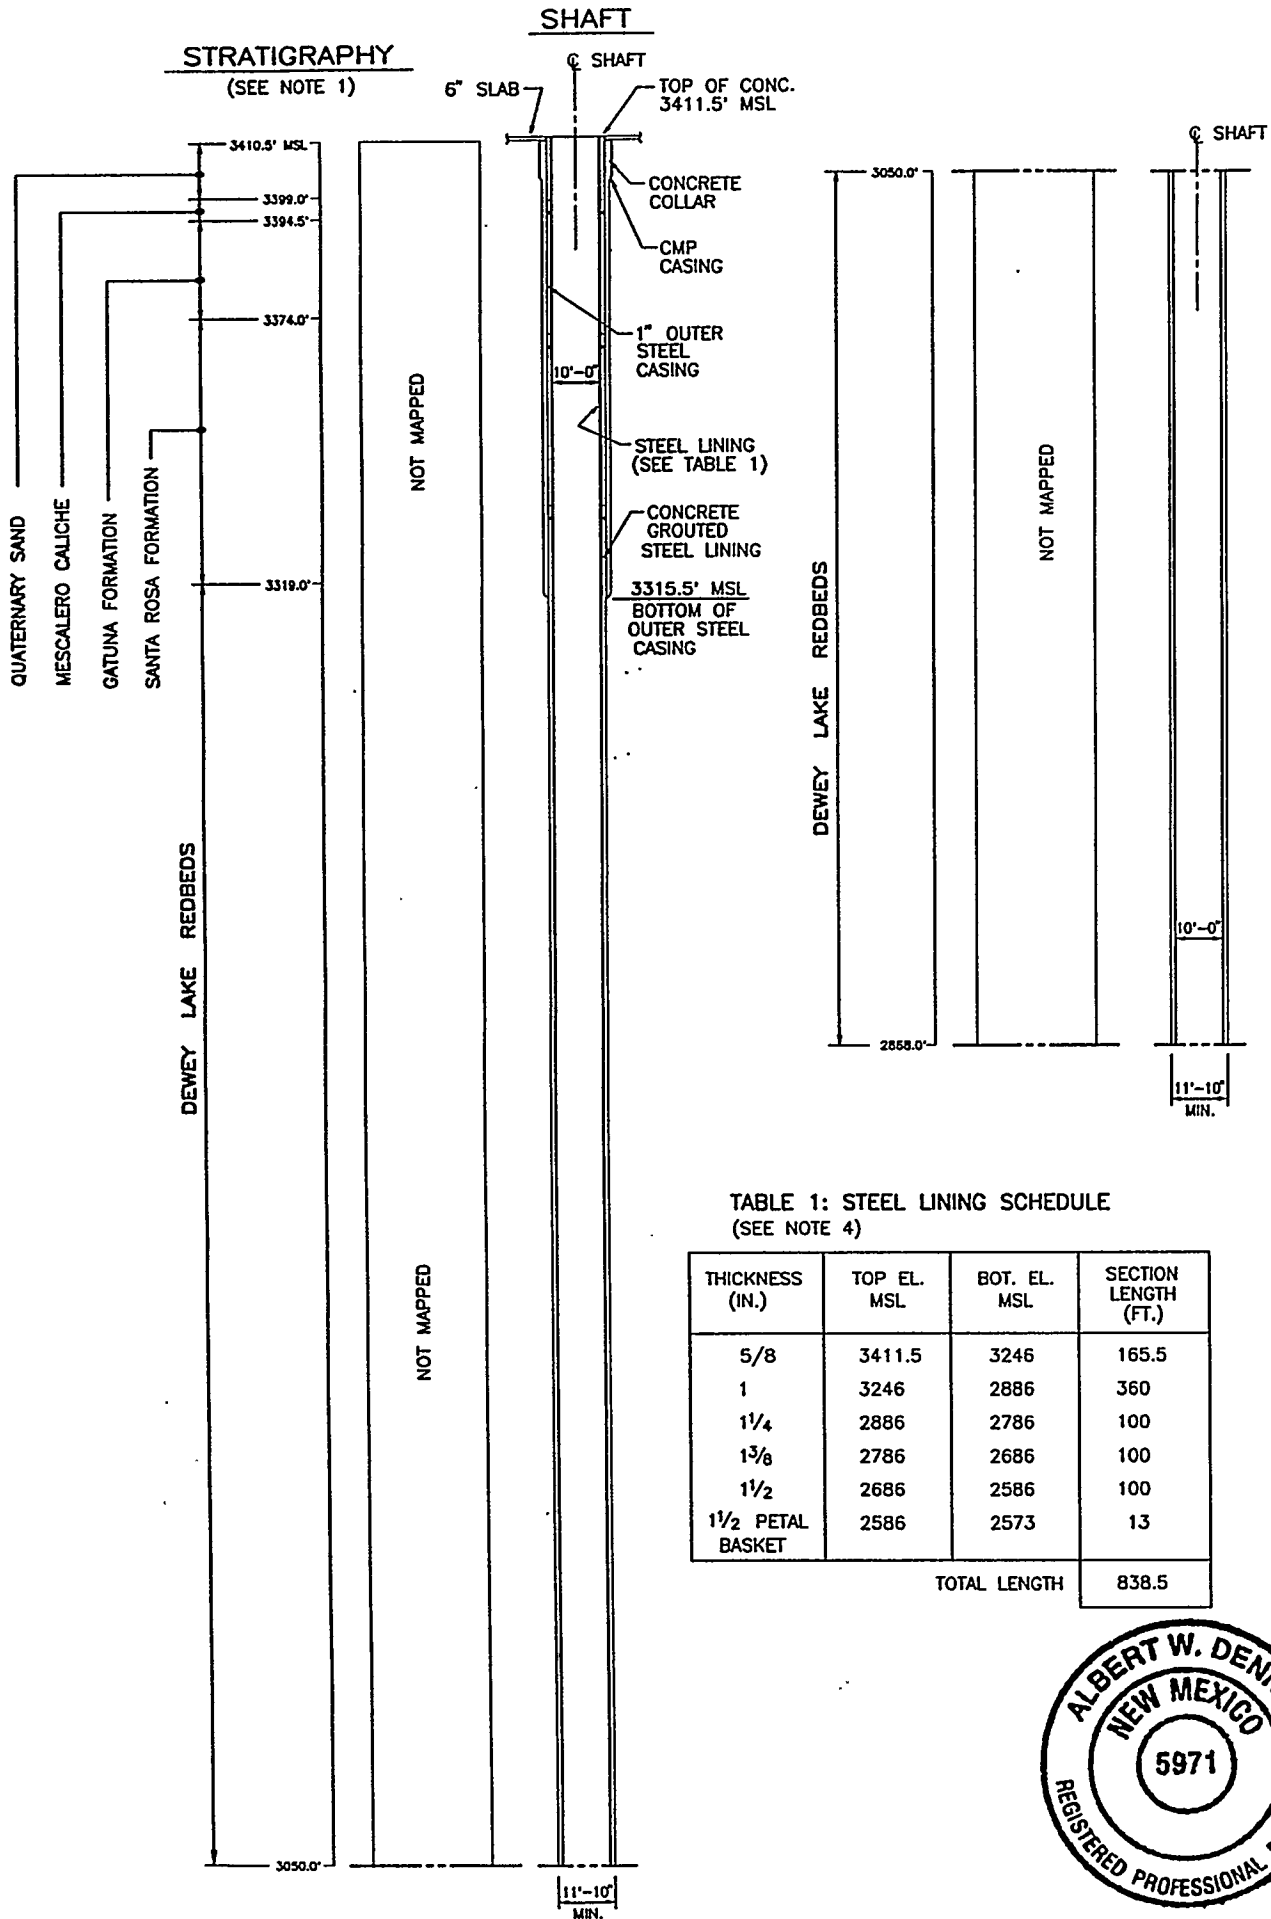

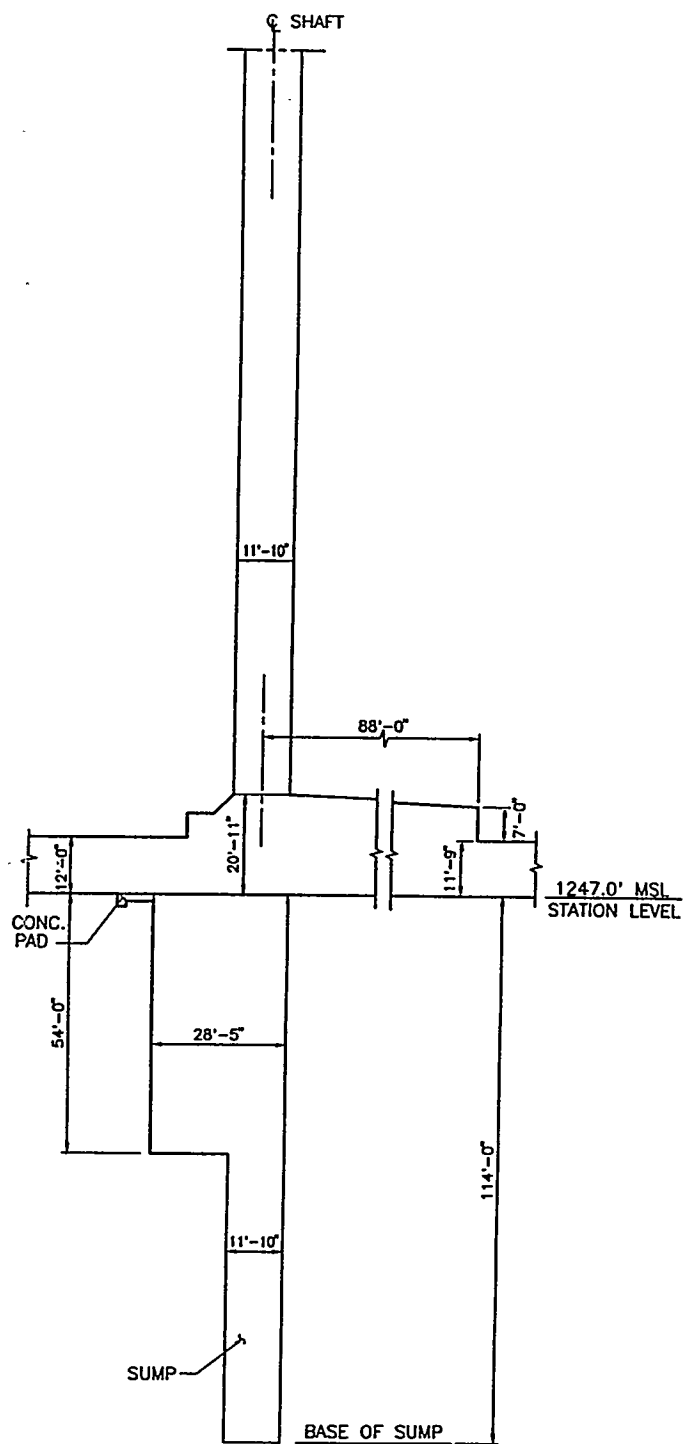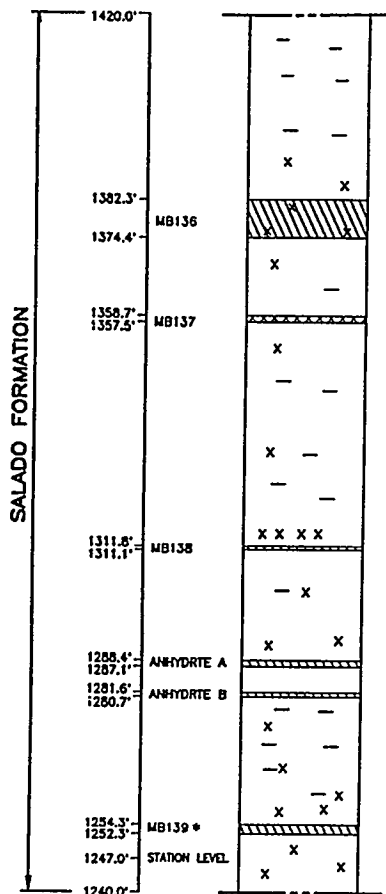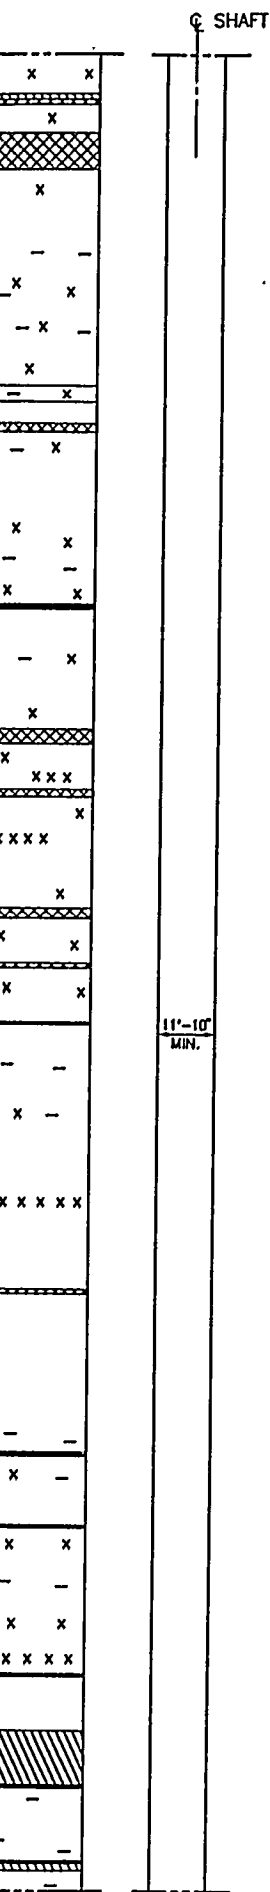


NOTES:

1. SEE SHT. 1 FOR GENERAL NOTES AND ABBREVIATIONS
2. SEE SHT. 17 FOR LITHOLOGY AND NOTES.




A. W. Dennis 8-2-96

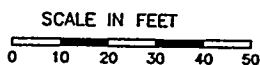

0	8/2/96	ISSUED FOR RECORDS PACKAGE	BY	CK.	APP.
REV.	DATE	DESCRIPTION	BY	CK.	APP.
SANDIA NATIONAL LABORATORIES					
WIPP A/E SUPPORT			CONTRACT NO: AG-4909		
WIPP SHAFT SEALING SYSTEM SALADO FORMATION SALT HANDLING SHAFT STRATIGRAPHY & AS-BUILT ELEMENTS			NAME	DATE	
			BY	8/4/96	
			CK.	SAR 8/4/96	
			APP.	HLS 8/4/96	
			APP.	COM 8/5/96	
			APP.	HLS 8/5/96	
PARSONS BRINCKERHOFF ENERGY SERVICES, INC		SCALE:	SIZE B	SNL DWG. NO. SNL-007	SHEET NO. 18 OF 28

STRATIGRAPHY (SEE NOTE 2)

SALADO FORMATION

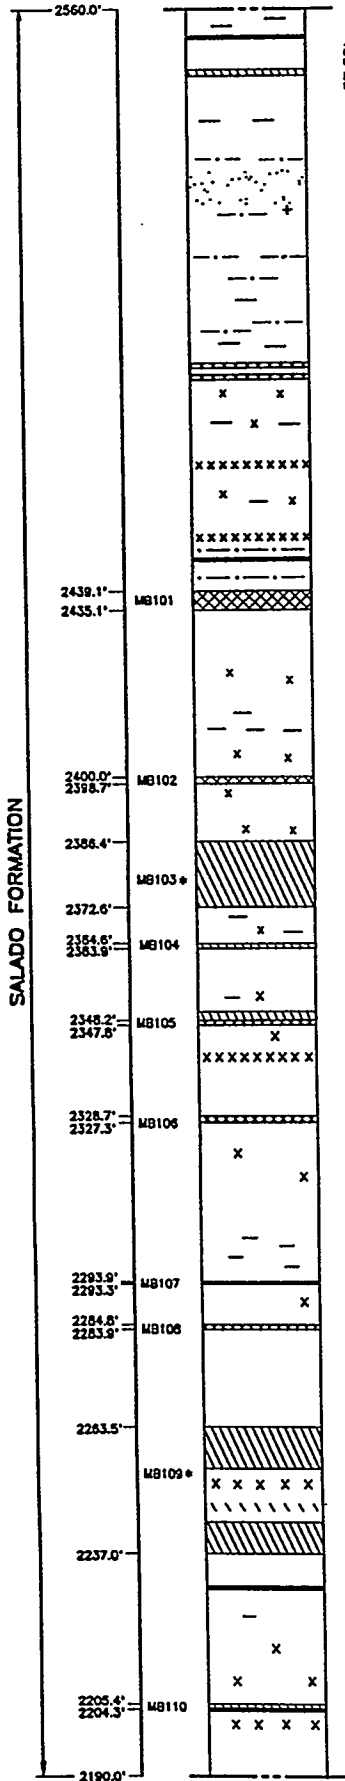

G SHAFT

TOP OF KEY

2560.0' MSL
RUSTLER/SALADO *
INTERFACE


CHEMICAL
SEAL RING
(TYP. OF 3)

2529.0' MSL
BOTTOM OF KEY

11'-10"
MIN.

UNLINED
SHAFT


SALADO FORMATION

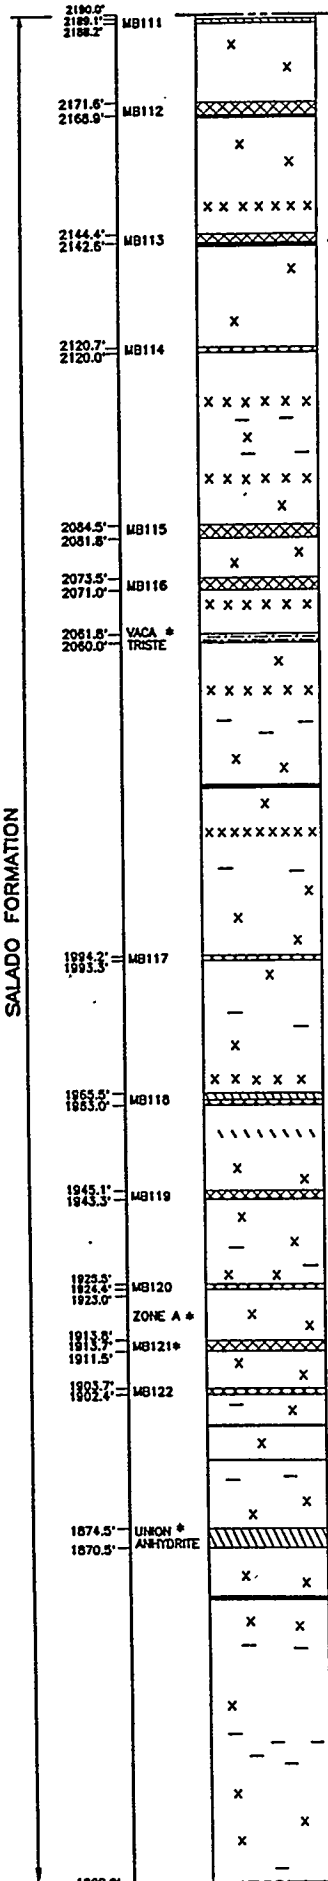

G SHAFT

11'-10"
MIN.

SALADO FORMATION

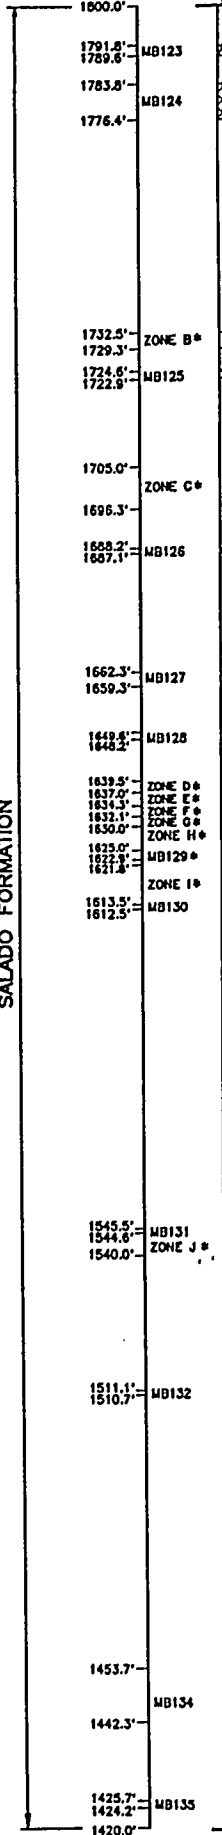


1. SEE SHT. 1 FOR GENERAL NOTES, LEGEND AND ABBREVIATIONS.
2. SEE SHT. 17 FOR LITHOLOGY AND NOTES.
3. DEPTHS SHOWN ARE DISTANCES BELOW THE TOP OF CONCRETE, LOCATED AT EL. 3411.5' ABOVE MSL USGS 1927 NORTH AMERICAN DATUM.



A. W. Dennis 8-2-96

SCALE IN FEET

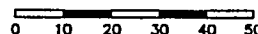




0	8/2/96	ISSUED FOR RECORDS PACKAGE										<i>SLP</i> <i>SLP</i> <i>SLP</i>								
REV.	DATE	DESCRIPTION										BY	CK. APP							
 SANDIA NATIONAL LABORATORIES																				
WIPP A/E SUPPORT												CONTRACT NO: AG-4809								
WIPP SHAFT SEALING SYSTEM NEAR-SURFACE/RUSTLER FORMATIONS SALT HANDLING SHAFT STRATIGRAPHY & SEALING SUBSYSTEM PROFILE												NAME	DATE							
												BY	<i>SLP</i> <i>8/2/96</i>							
												CK.	<i>SLP</i> <i>8/2/96</i>							
												APP.	<i>MSL</i> <i>8/2/96</i>							
												APP.	<i>CPLM</i> <i>8/2/96</i>							
												APP.	<i>SLP</i> <i>8/2/96</i>							
PARSONS BRINCKERHOFF ENERGY SERVICES, INC						SCALE:		SIZE 8		SNL DWG. NO. SNL--007				SHEET NO. 19 OF 28						


STRATIGRAPHY

(SEE NOTE 2)

SHAFT

DEPTH
(SEE NOTE 3)

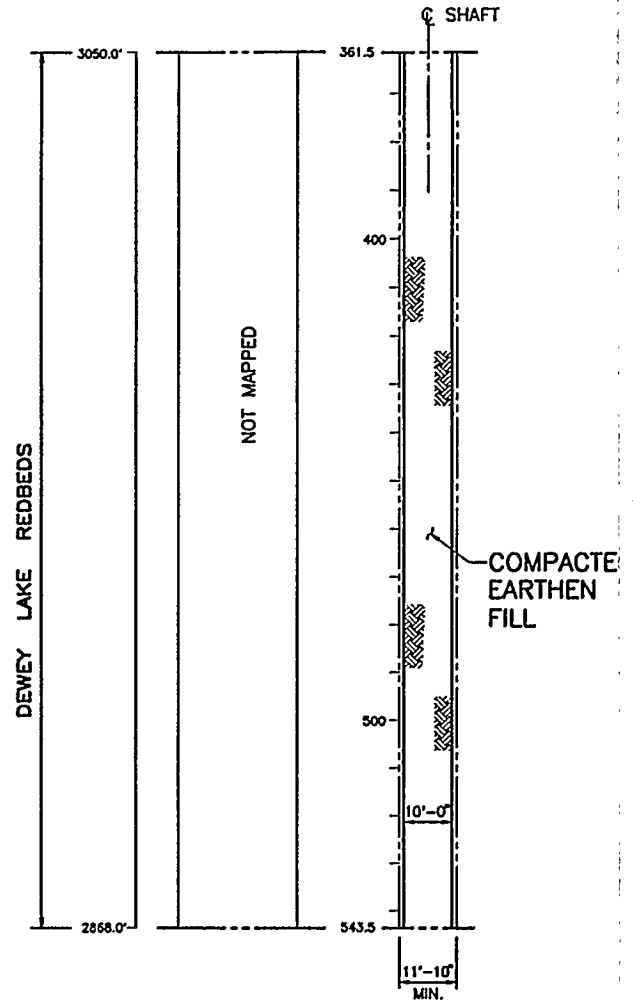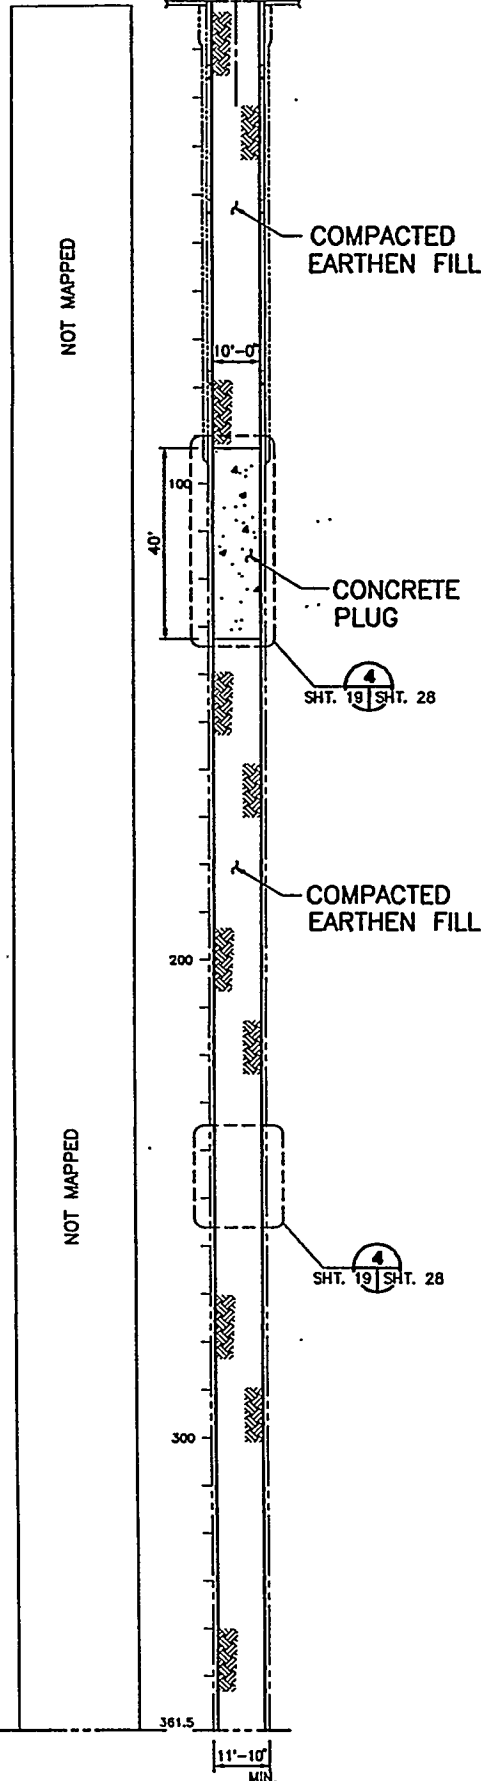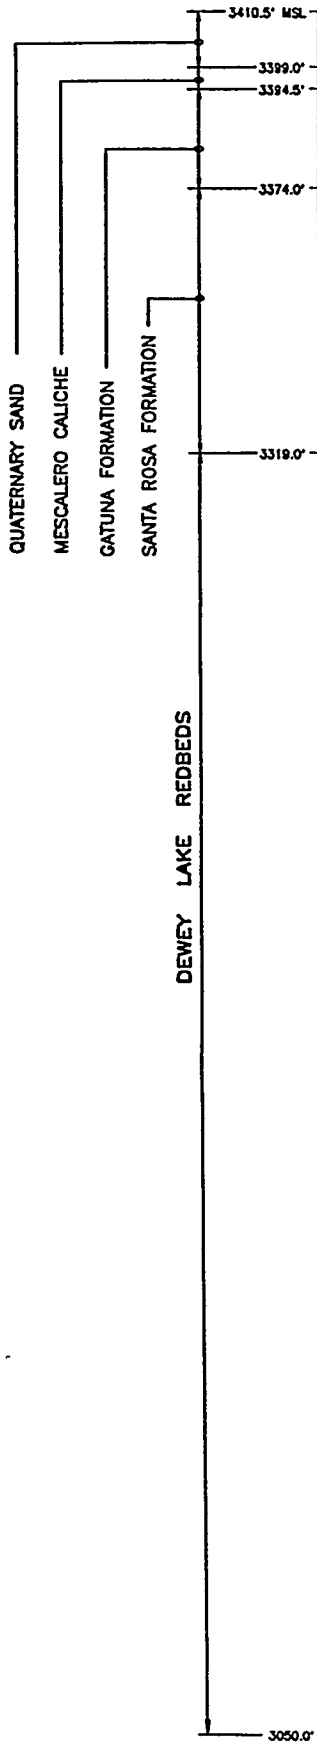

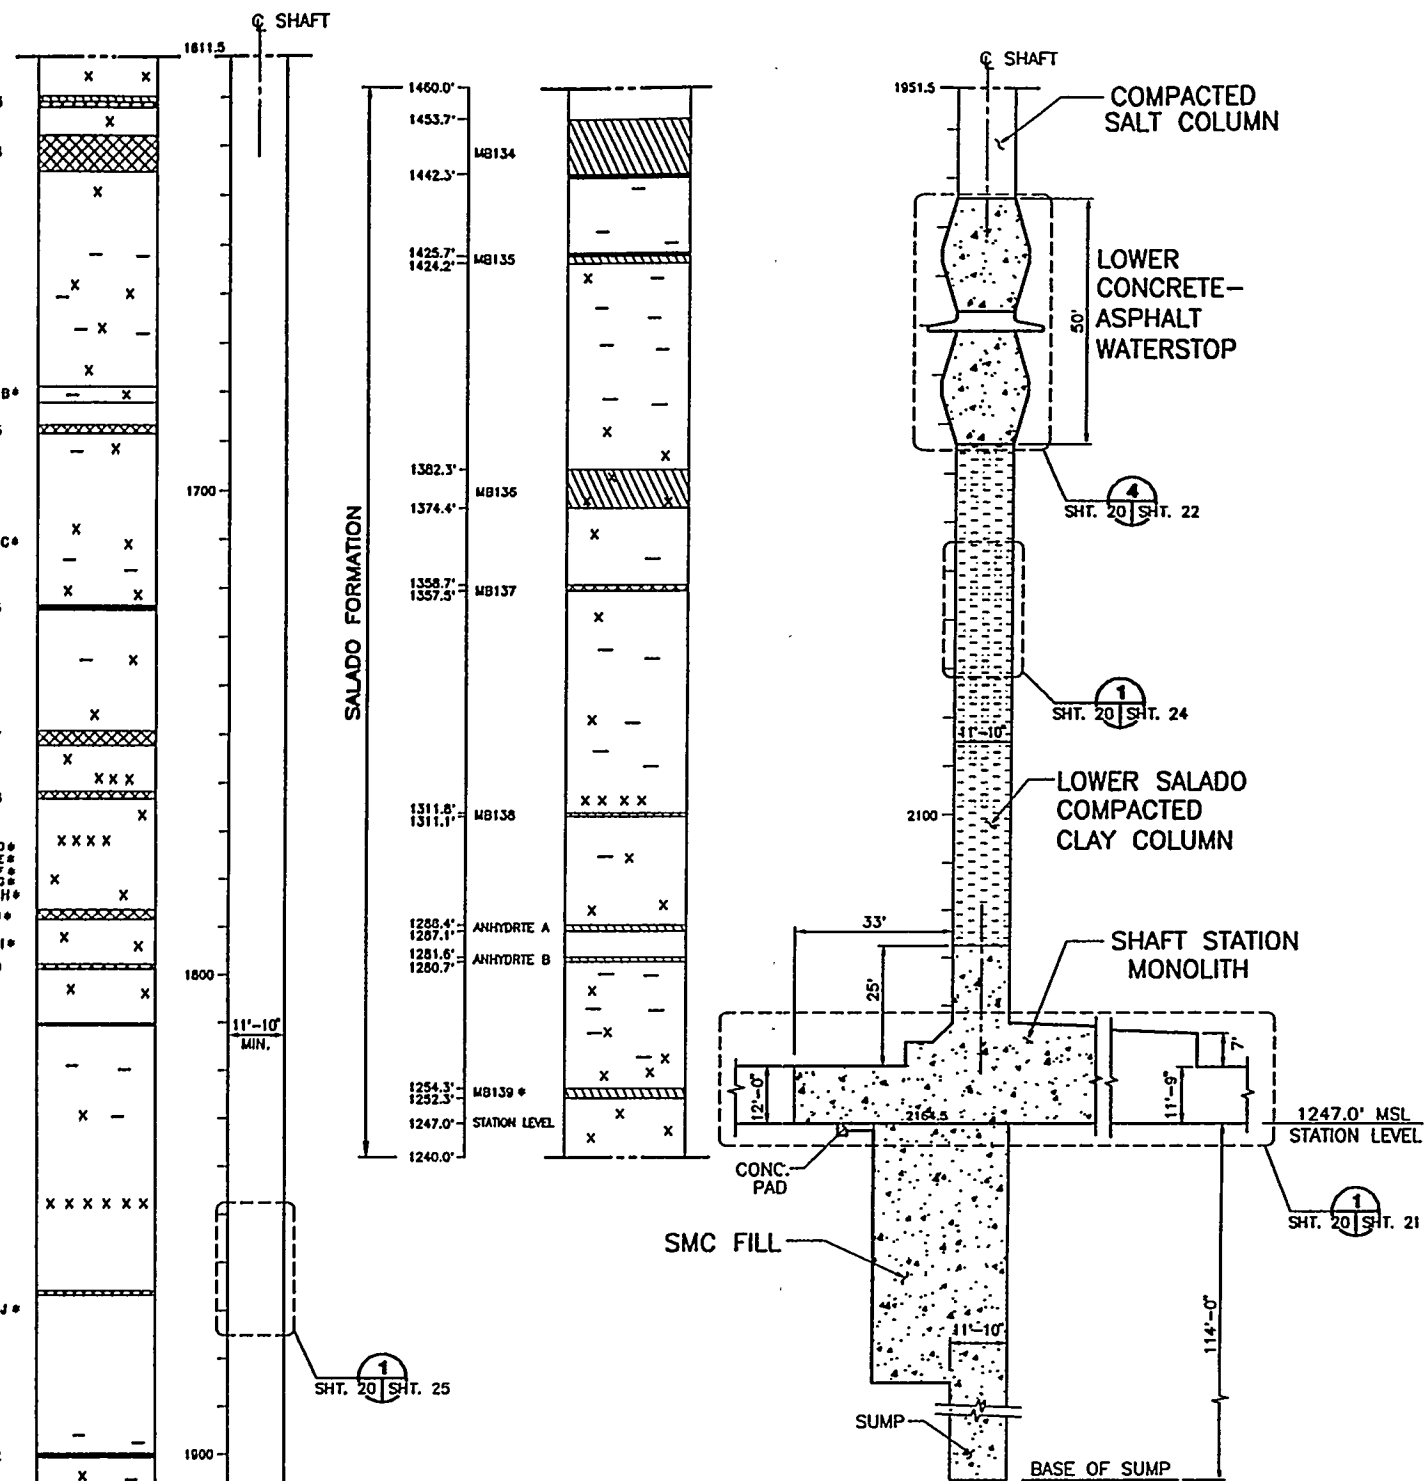

E-23


NOTES, LEGEND AND
AND NOTES.




A.W. Dennis 8-2-96
SCALE IN FEET
0 10 20 30 40 50


0	8/2/96	ISSUED FOR RECORDS PACKAGE	BY	CK.	APP.
REV.	DATE	DESCRIPTION	BY	CK.	APP.
SANDIA NATIONAL LABORATORIES WIPP A/E SUPPORT WIPP SHAFT SEALING SYSTEM SALADO FORMATION SALT HANDLING SHAFT STRATIGRAPHY & SEALING SUBSYSTEM PROFILE					
CONTRACT NO: AC-4909			NAME	DATE	
			BY	DATE	
			CK.	DATE	
			APP.	DATE	
			APP.	DATE	
			APP.	DATE	
PARSONS BRINCKERHOFF ENERGY SERVICES, INC			SCALE:	SIZE	SNL DWG. NO.
			B	B	SNL-007
					SHEET NO.
					20 OF 28

(SEE NOTE 2)

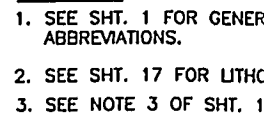

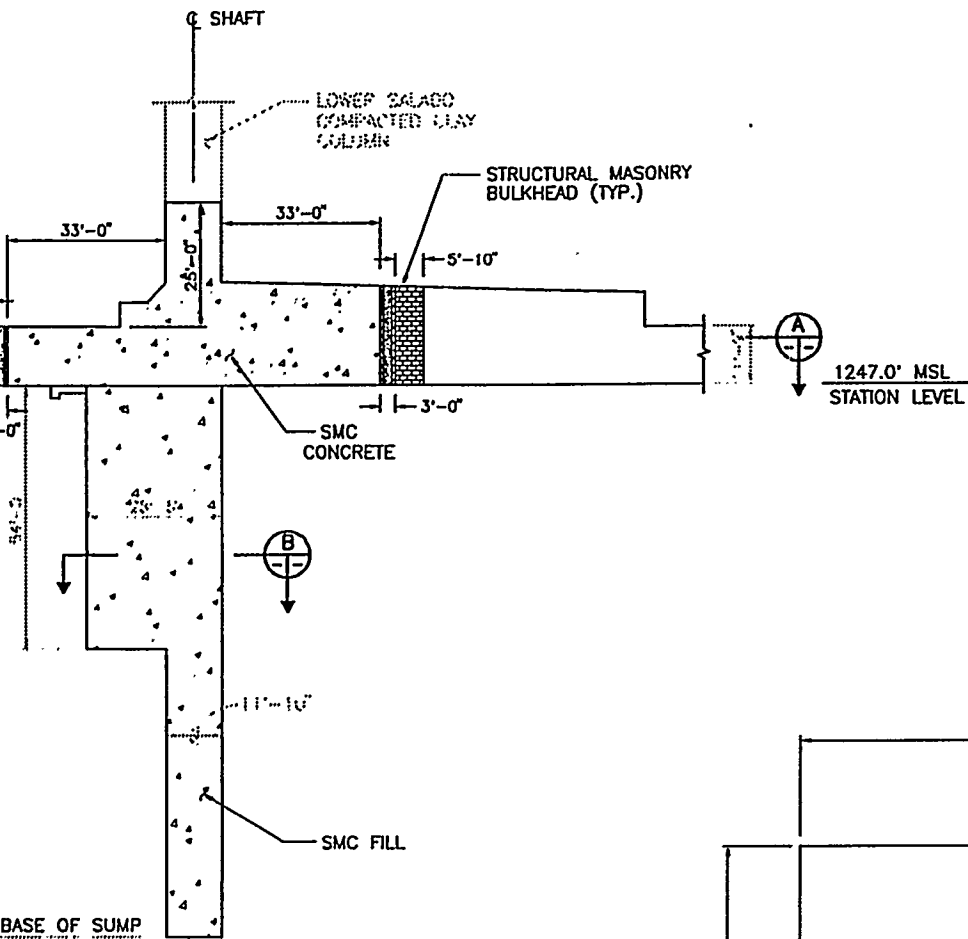

DETAIL 1
SHT. 20 | SHT. 21
SCALE IN FEET
0 10 20 30 40 50

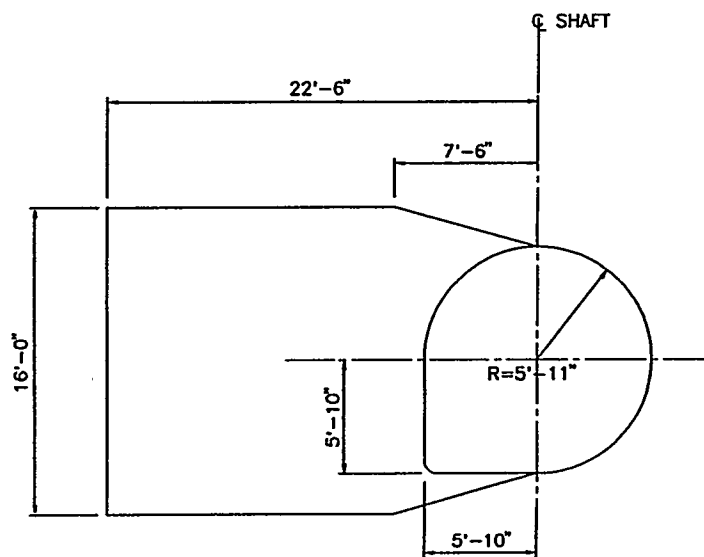

SECTION B

SCALE IN FEET
0 5 10 15 20


NOTES:

- SEE SHT. 1 FOR GENERAL NOTES, LEGEND AND ABBREVIATIONS.



Albert W. Dennis
8-2-96

0	8/2/96	ISSUED FOR RECORDS PACKAGE	BY	CK	APP
REV.	DATE	DESCRIPTION	BY	CK	APP
SANDIA NATIONAL LABORATORIES			CONTRACT NO: AG-4909		
WIPP A/E SUPPORT			NAME		
WIPP SHAFT SEALING SYSTEM			DATE		
SALT HANDLING SHAFT			BY		
SHAFT STATION MONOLITH			CK		
			APP		
			APP		
PARSONS BRINCKERHOFF ENERGY SERVICES, INC			SCALE:	SIZE	SNL DWG. NO.
				B	SNL-007
					SHEET NO.
					21 OF 28

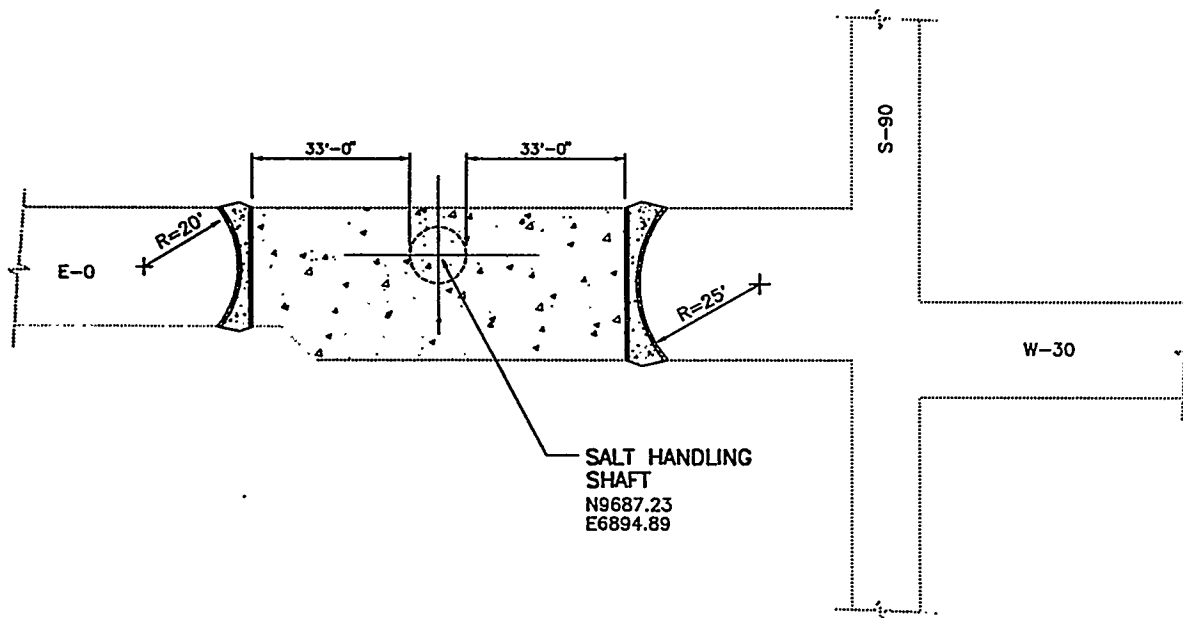



SALT HANDLING
SHAFT
N9687.23
E6894.89

SECTION




SCALE IN FEET

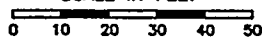


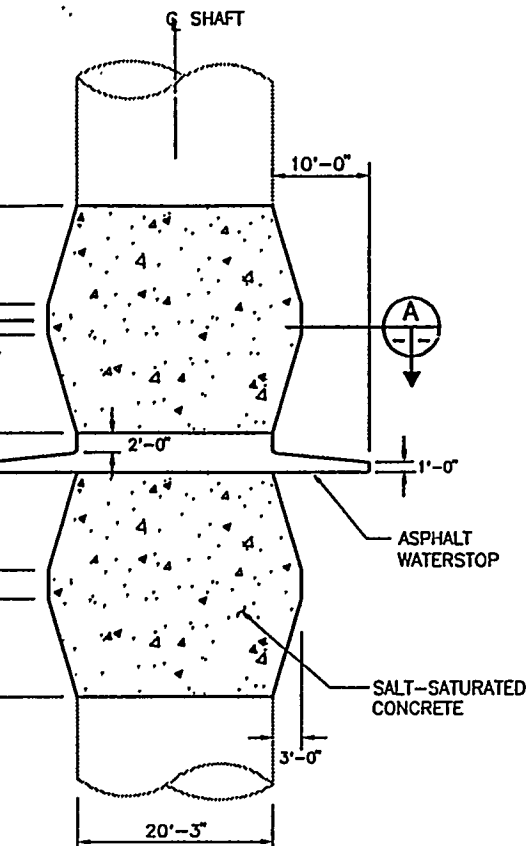

DETAIL 2
R INTAKE SHAFT SHT. 10 SHT. 22

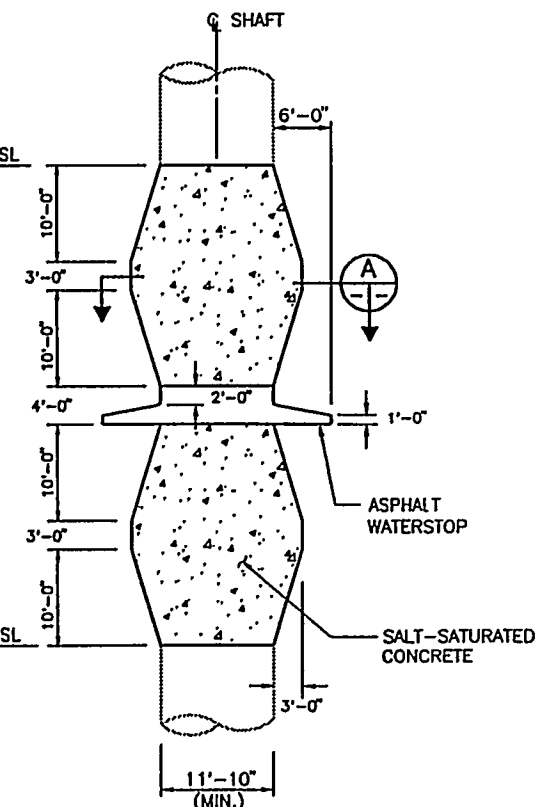

DETAIL 4
SALT HANDLING SHAFT SHT. 20 SHT. 22

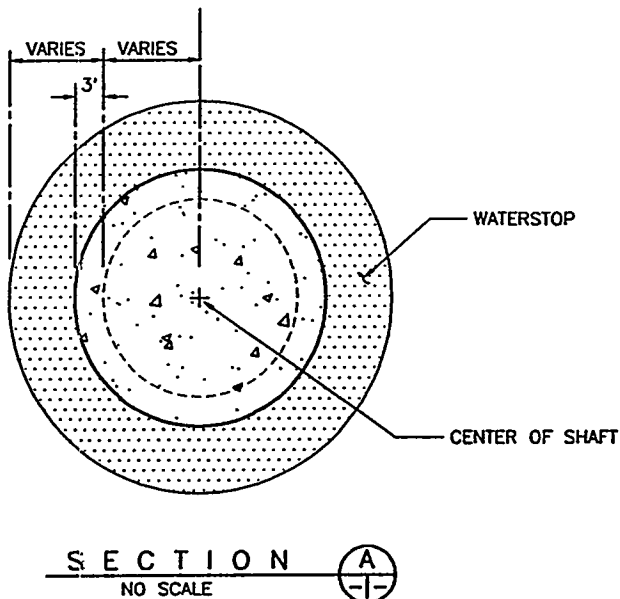


Albert W. Dennis
4-2-96

SCALE IN FEET
0 5 10 15 20 25

0	8/2/96	ISSUED FOR RECORDS PACKAGE	CH	SA	AM
REV.	DATE	DESCRIPTION	BY	CK.	APP.
SANDIA NATIONAL LABORATORIES WIPP A/E SUPPORT WIPP SHAFT SEALING SYSTEM CONCRETE-ASPHALT WATERSTOP IN SALADO FORMATION					
CONTRACT NO: AG-4909			NAME	DATE	
			BY	2/20/96	
			CK.	SAE 8/2/96	
			APP.	CH 5/2/96	
			APP.	CH 5/2/96	
			APP.	CH 5/2/96	
PARSONS BRINCKERHOFF ENERGY SERVICES, INC	SCALE:	SIZE B	SNL DWG. NO. SNL-007	SHEET NO. 22 OF 28	

E-25

UPPER PLUG	MIDDLE PLUG	LOWER PLUG
2439.0'	2037.5'	1432.0' MSL

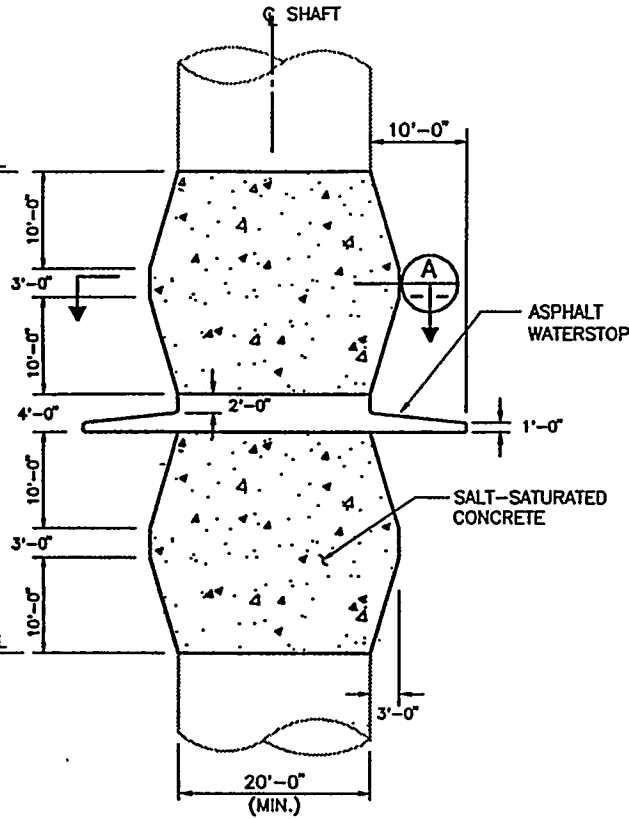

UPPER PLUG	MIDDLE PLUG	LOWER PLUG
2389.0'	1987.5'	1382.0' MSL

UPPER PLUG	MIDDLE PLUG	LOWER PLUG
2447.0'	2053.0'	1439.5' MSL


UPPER PLUG	MIDDLE PLUG	LOWER PLUG
2397.0'	2003.0'	1389.5' MSL

DETAIL

WASTE SHAFT

SHT. 5 | SHT. 22

UPPER PLUG	MIDDLE PLUG	LOWER PLUG
2432.0'	2042.0'	1433.0' MSL

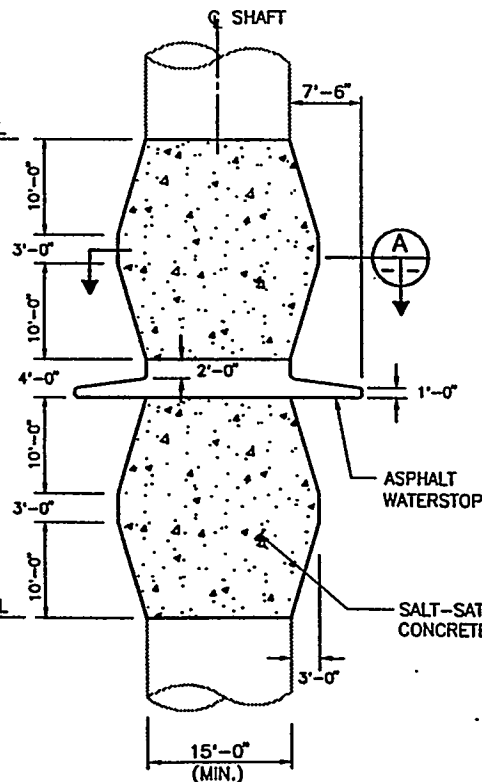

UPPER PLUG	MIDDLE PLUG	LOWER PLUG
2382.0'	1992.0'	1383.0' MSL


UPPER PLUG	MIDDLE PLUG	LOWER PLUG
2436.0'	2051.0'	1441.0' MSL

UPPER PLUG	MIDDLE PLUG	LOWER PLUG
2386.0'	2001.0'	1391.0' MSL

DETAIL

EXHAUST SHAFT

SHT. 15 | SHT. 22

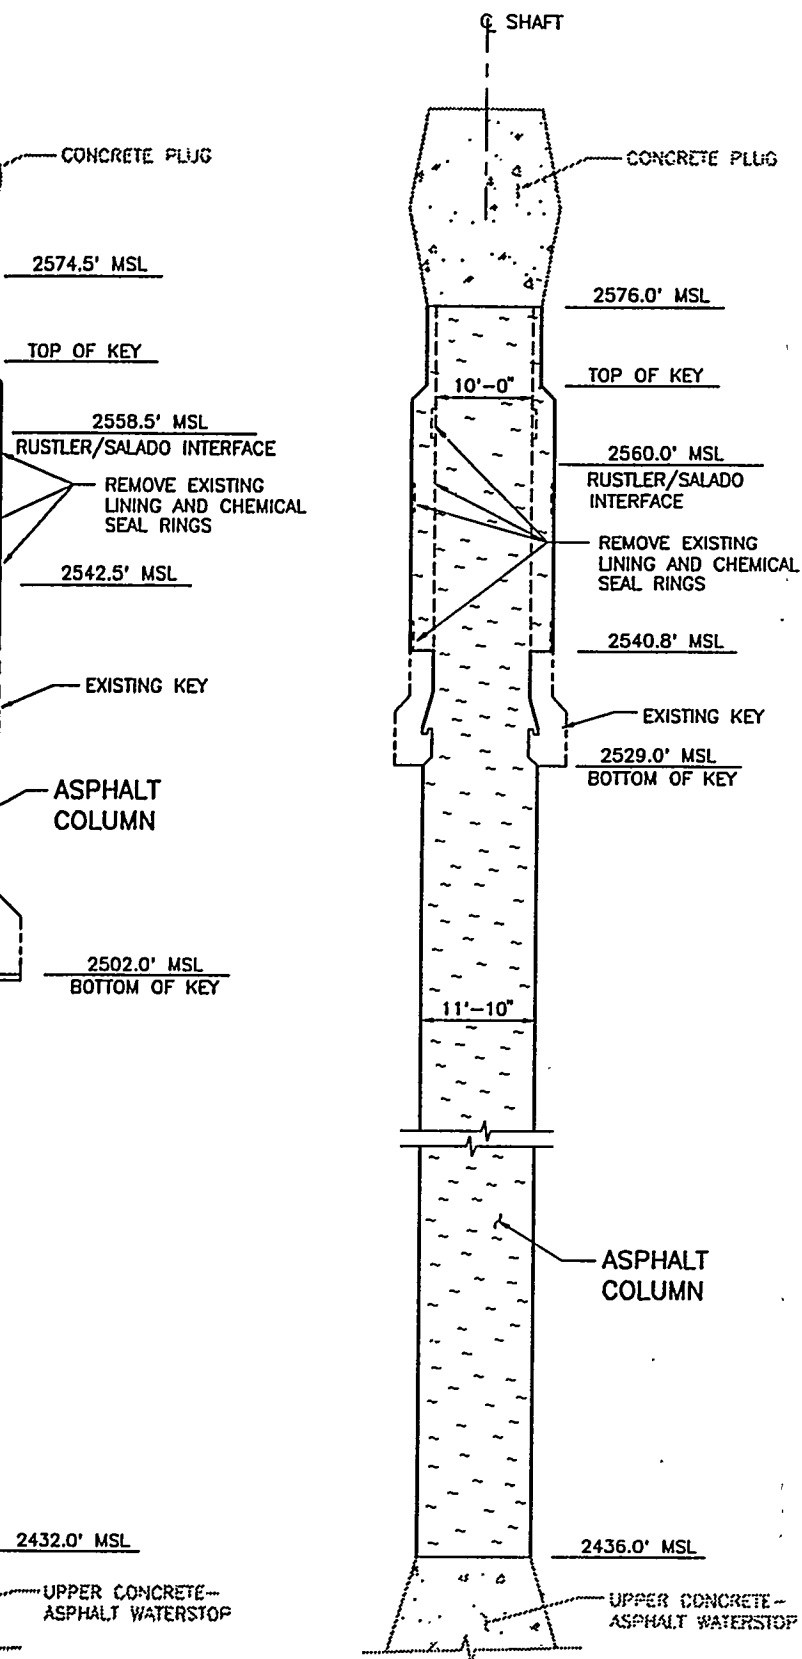

Albert W. Dennis
8-2-96


SCALE IN FEET
0 5 10 15 20 25

3
SHT. 15 | SHT. 23

DETAIL
SALT HANDLING SHAFT
4
SHT. 20 | SHT. 23


0	8/2/96	ISSUED FOR RECORDS PACKAGE	BY	CK.	APP.
REV.	DATE	DESCRIPTION	BY	CK.	APP.
SANDIA NATIONAL LABORATORIES					
WIPP A/E SUPPORT			CONTRACT NO: AG-4909		
WIPP SHAFT SEALING SYSTEM			NAME	DATE	
ASPHALT COLUMN			BY	8/2/96	
			CK.	8/2/96	
			APP.	8/2/96	
			APP.	8/2/96	
PARSONS BRINCKERHOFF ENERGY SERVICES, INC		SCALE:	SIZE 8	SNL DWG. NO. SNL-007	SHEET NO. 23 OF 28

E-26

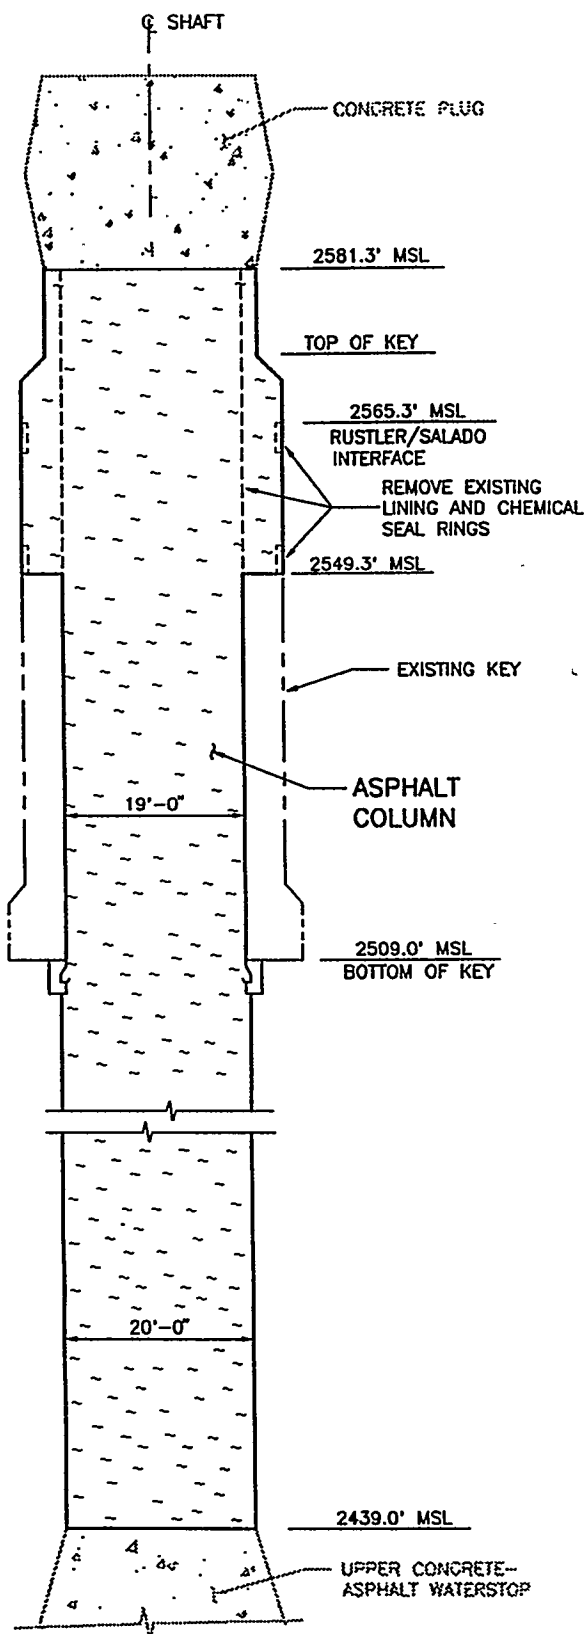


DETAIL
WASTE SHAFT

1
SHT. 5 | SHT. 23

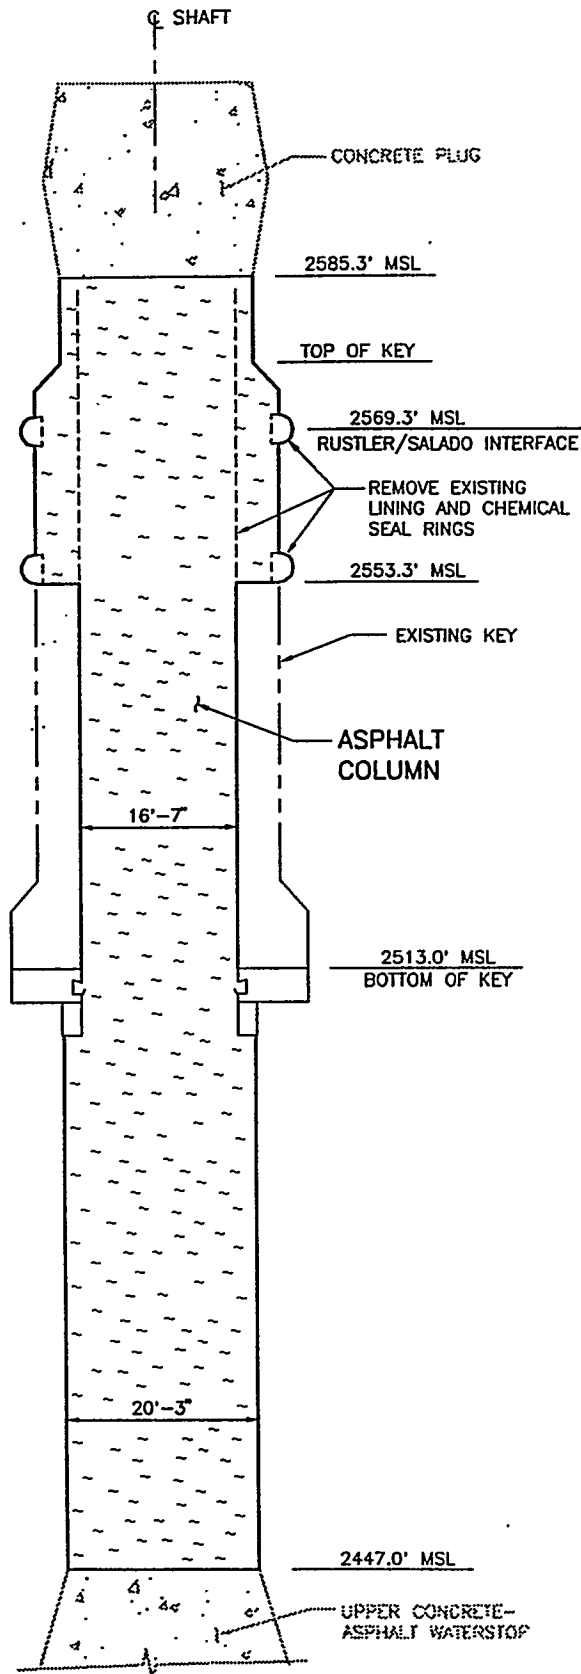

DETAIL
AIR INTAKE SHAFT

2
SHT. 10 | SHT. 23

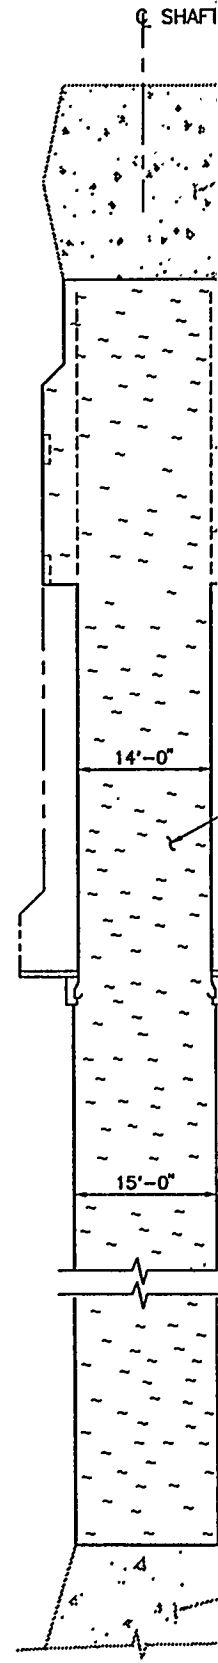

DETAIL
EXHAUST SHAFT

FILE 1



SHAFT	NOMINAL SHAFT DIAMETER D	UPPER SALADO COMPACTED CLAY COLUMN			LOWER SALADO COMPACTED CLAY COLUMN		
		TOP EL. (FT. MSL)	BOTTOM EL. (FT. MSL)	TOTAL HT. (FT.)	TOP EL. (FT. MSL)	BOTTOM EL. (FT. MSL)	TOTAL HT. (FT.)
WASTE	20'-0"	2389.0	2037.5	351.5	1382.0	1286.0	96.0
AIR INTAKE	20'-3"	2397.0	2053.0	344.0	1389.5	1296.0	93.5
HAUST	15'-0"	2382.0	2042.0	340.0	1383.0	1285.0	98.0
ALT HANDLING	11'-10"	2386.0	2051.0	335.0	1391.0	1284.0	107.0



Albert W. Dennis
9-2-96

0	8/2/96	ISSUED FOR RECORDS PACKAGE	BY	CK.	APP.
REV.	DATE	DESCRIPTION	BY	CK.	APP.
SANDIA NATIONAL LABORATORIES					
WIPP A/E SUPPORT			CONTRACT NO: AG-4909		
WIPP SHAFT SEALING SYSTEM			NAME	DATE	
			BY	8/2/96	
			CK.	SAP 8/2/96	
UPPER AND LOWER SALADO COMPACTED CLAY COLUMNS			APP.	M.S.K. 9/4/96	
			APP.	C.M. 9/4/96	
			APP.	M.D. 9/4/96	
PARSONS BRINCKERHOFF ENERGY SERVICES, INC		SCALE:	SIZE B	SNL DWG. NO. SNL-007	SHEET NO. 24 OF 28

E-27

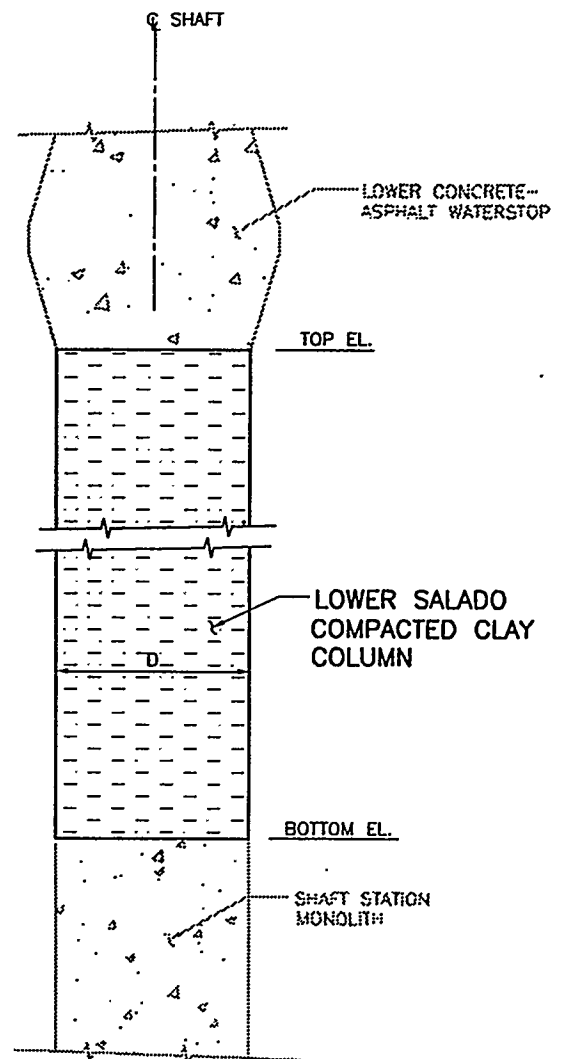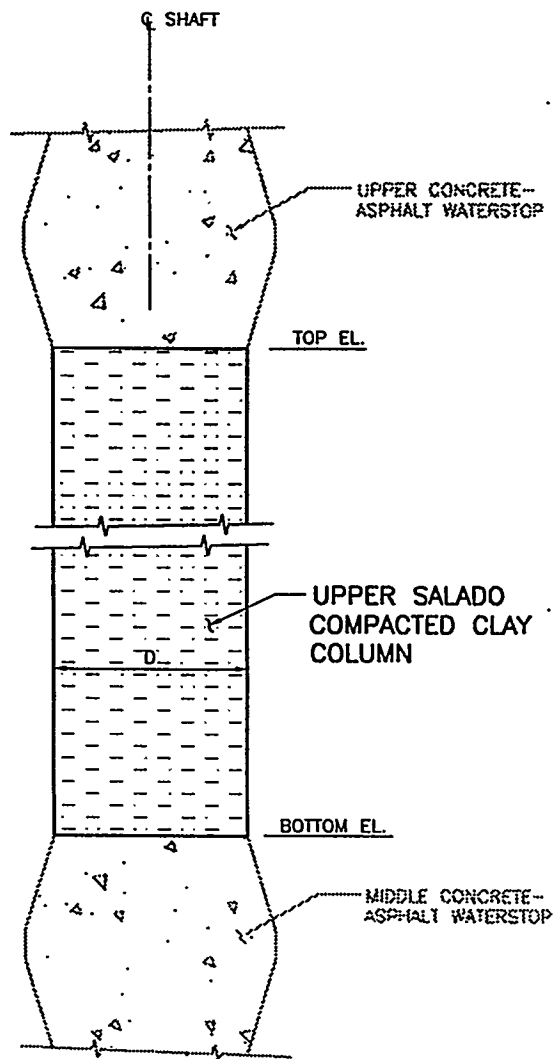

DETAIL

SEE TABLE 1 FOR DETAILS
NO SCALE

1
SHT. 5 | SHT. 24
SHT. 10
SHT. 15
SHT. 20

BLE 1


SHAFT	NOMINAL SHAFT DIAMETER D	COMPACTED SALT COLUMN		
		TOP EL. (FT. MSL)	BOTTOM EL. (FT. MSL)	TOTAL H _T . (FT.)
ASTE	20'-0"	1987.5	1432.0	555.5
AIR ITAKE	20'-3"	2003.0	1439.5	563.5
HAUST	15'-0"	1992.0	1433.0	559.0
ALT NDLING	11'-10"	2001.0	1441.0	560.0



Albert W. Dennis
8-2-96

0	8/2/96	ISSUED FOR RECORDS PACKAGE	BY	CK.	APP.
REV.	DATE	DESCRIPTION	BY	CK.	APP.
SANDIA NATIONAL LABORATORIES					
WIPP A/E SUPPORT			CONTRACT NO: AG-4909		
WIPP SHAFT SEALING SYSTEM COMPACTED SALT COLUMN			NAME	DATE	
			BY	8/2/96	
			CK.	SAP 8/2/96	
			APP.	WES 8/2/96	
			APP.	COP 8/2/96	
PARSONS BRINCKERHOFF ENERGY SERVICES, INC		SCALE:	SIZE 8	SNL DWG. NO. SNL-007	SHEET NO. 25 OF 28



E-28

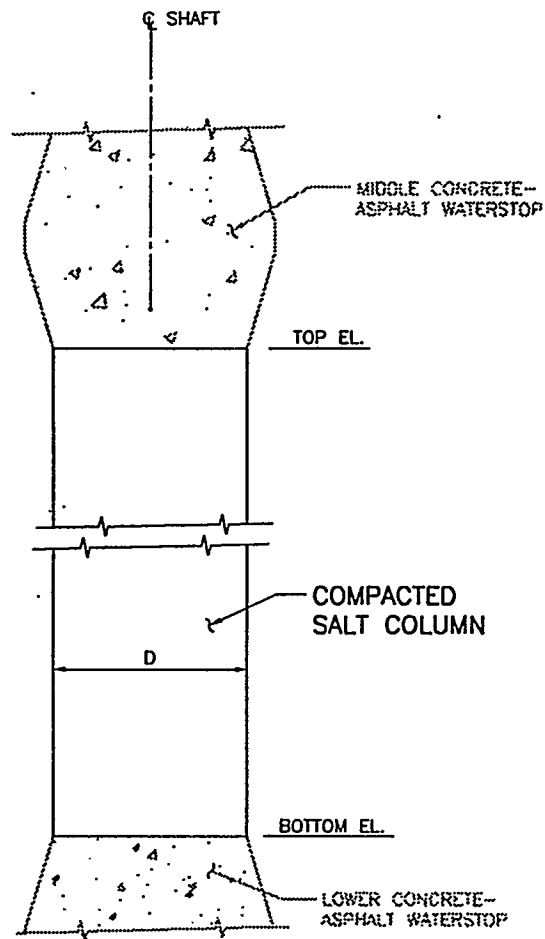

DETAIL

SEE TABLE 1 FOR DETAILS
NO SCALE

SHT. 5 | SHT. 25
 SHT. 10
 SHT. 15
 SHT. 20

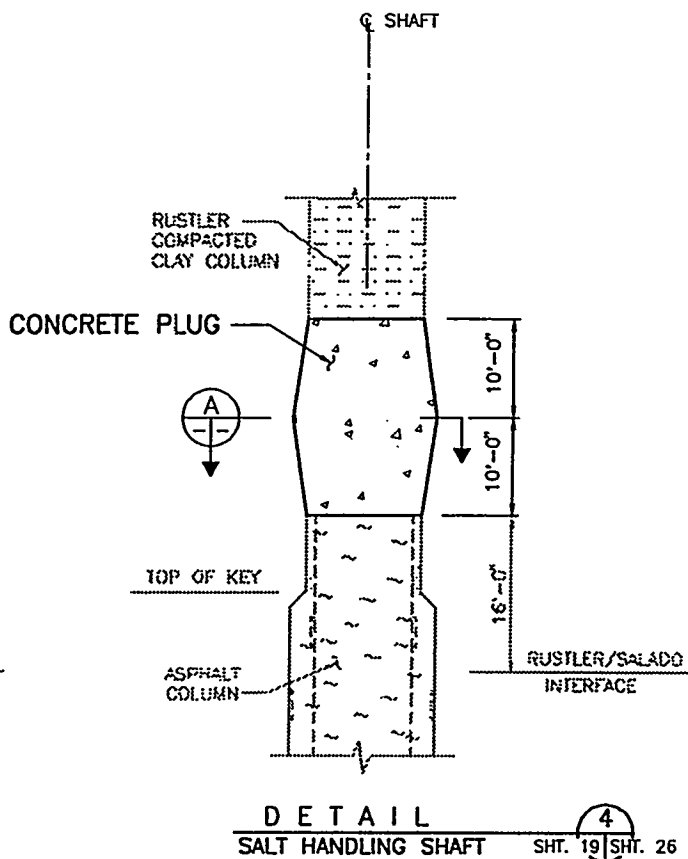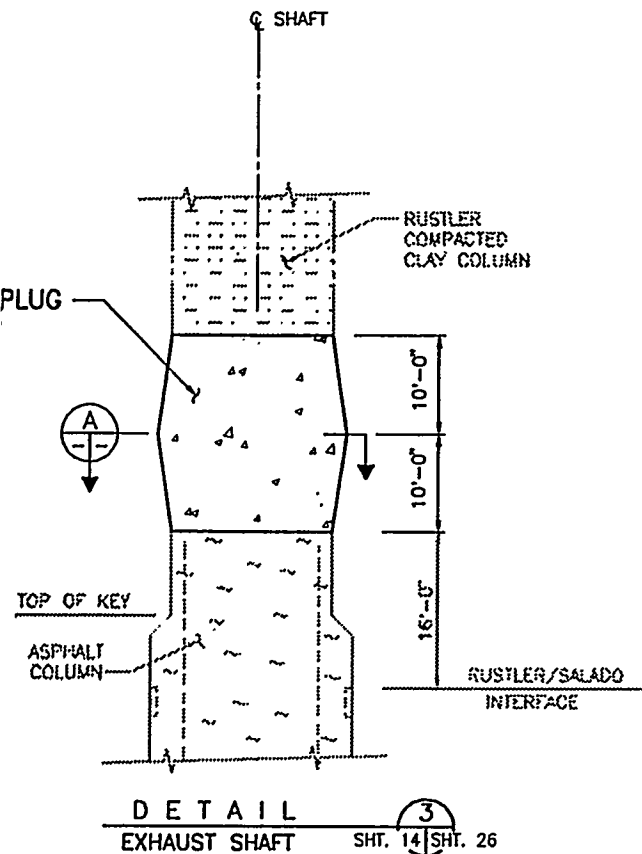

Albert W. Dennis
8-2-96

SCALE IN FEET
0 5 10 15 20 25

0	8/2/96	ISSUED FOR RECORDS PACKAGE	BY	CK.	APP.
REV.	DATE	DESCRIPTION	BY	CK.	APP.
SANDIA NATIONAL LABORATORIES					
WIPP A/E SUPPORT			CONTRACT NO: AG-4909		
WIPP SHAFT SEALING SYSTEM			NAME		
CONCRETE PLUG			DATE		
			BY		
			CK.		
			APP.		
			APP.		
PARSONS BRINCKERHOFF ENERGY SERVICES, INC			SCALE:	SIZE	SNL DWG. NO.
			B	SNL-007	SHEET NO.
					26 OF 28



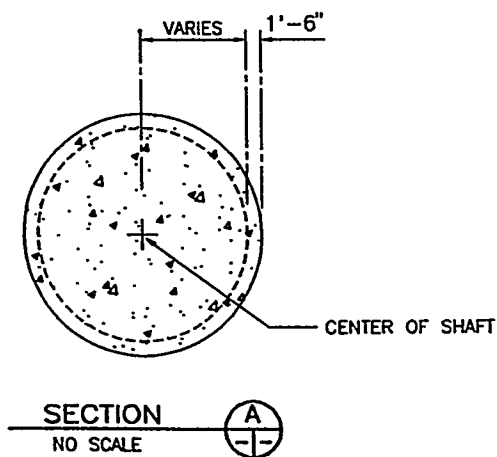



TABLE 1

SHAFT	NOMINAL SHAFT DIAMETER D	RUSTLER COMPACTED CLAY COLUMN		
		TOP EL. (FT. MSL)	BOTTOM EL. (FT. MSL)	TOTAL HT. (FT.)
WASTE	19'-0"	2836.0	2601.3	234.7
AIR INTAKE	16'-7"	2840.0	2605.3	234.7
EXHAUST	14'-0"	2829.0	2594.5	234.5
SALT HANDLING	10'-0"	2830.0	2596.0	234.0

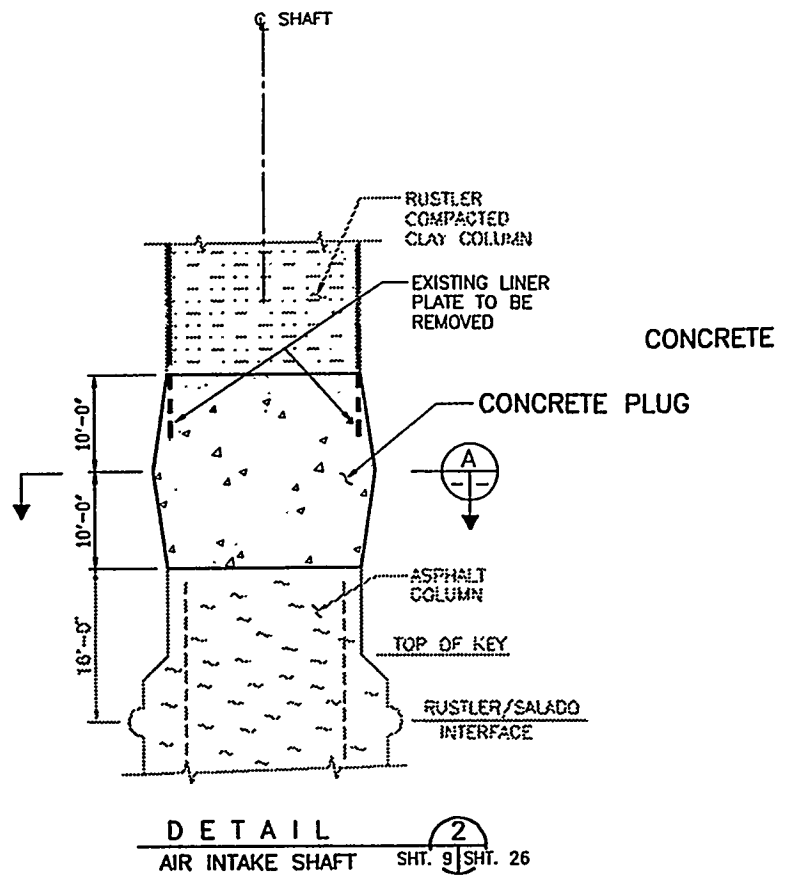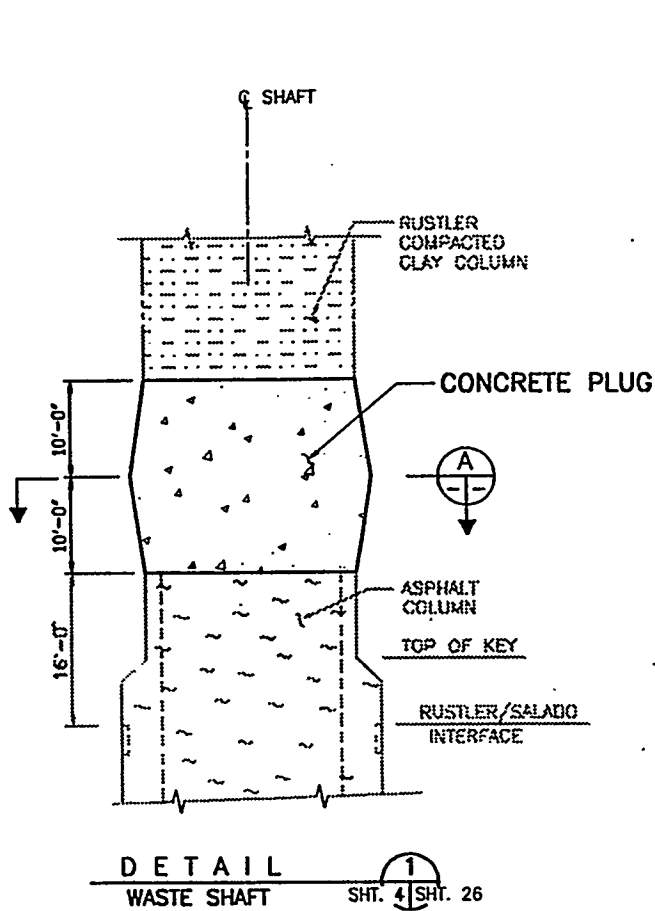

Albert W. Dennis
8-2-96


0	8/2/96	ISSUED FOR RECORDS PACKAGE	BY	CK.	APP.
REV.	DATE	DESCRIPTION	BY	CK.	APP.
SANDIA NATIONAL LABORATORIES					
WIPP A/E SUPPORT			CONTRACT NO: AG-4909		
WIPP SHAFT SEALING SYSTEM			NAME	DATE	
RUSTLER COMPACTED CLAY COLUMN			BY	8/2/96	
			CK.	8/2/96	
			APP.	8/2/96	
			APP.	8/2/96	
			APP.	8/2/96	
PARSONS BRINCKERHOFF ENERGY SERVICES, INC		SCALE:	SIZE B	SNL DWG. NO. SNL-007	SHEET NO. 27 OF 28

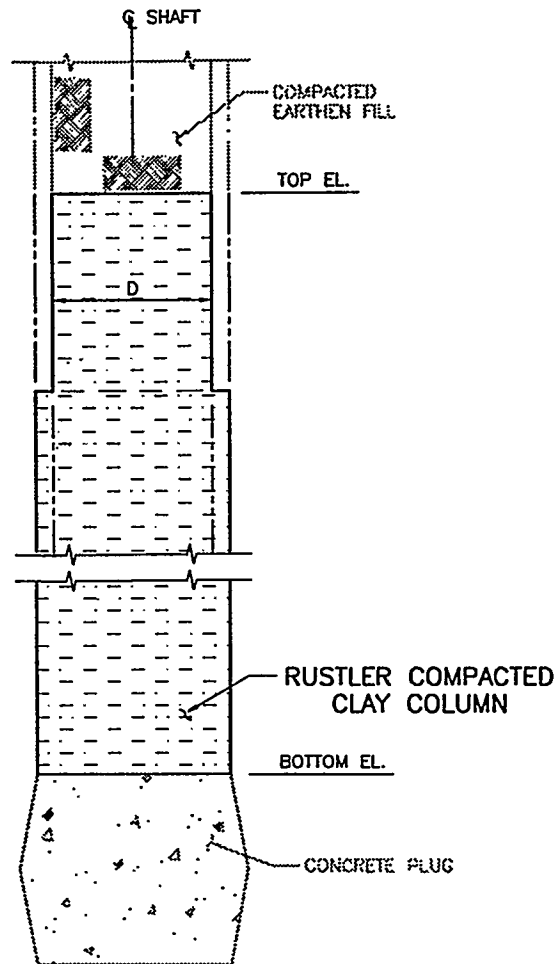

DETAIL

SEE TABLE 1 FOR DETAILS
NO SCALE

SHT. 4	1	SHT. 27
SHT. 9		
SHT. 14		
SHT. 19		

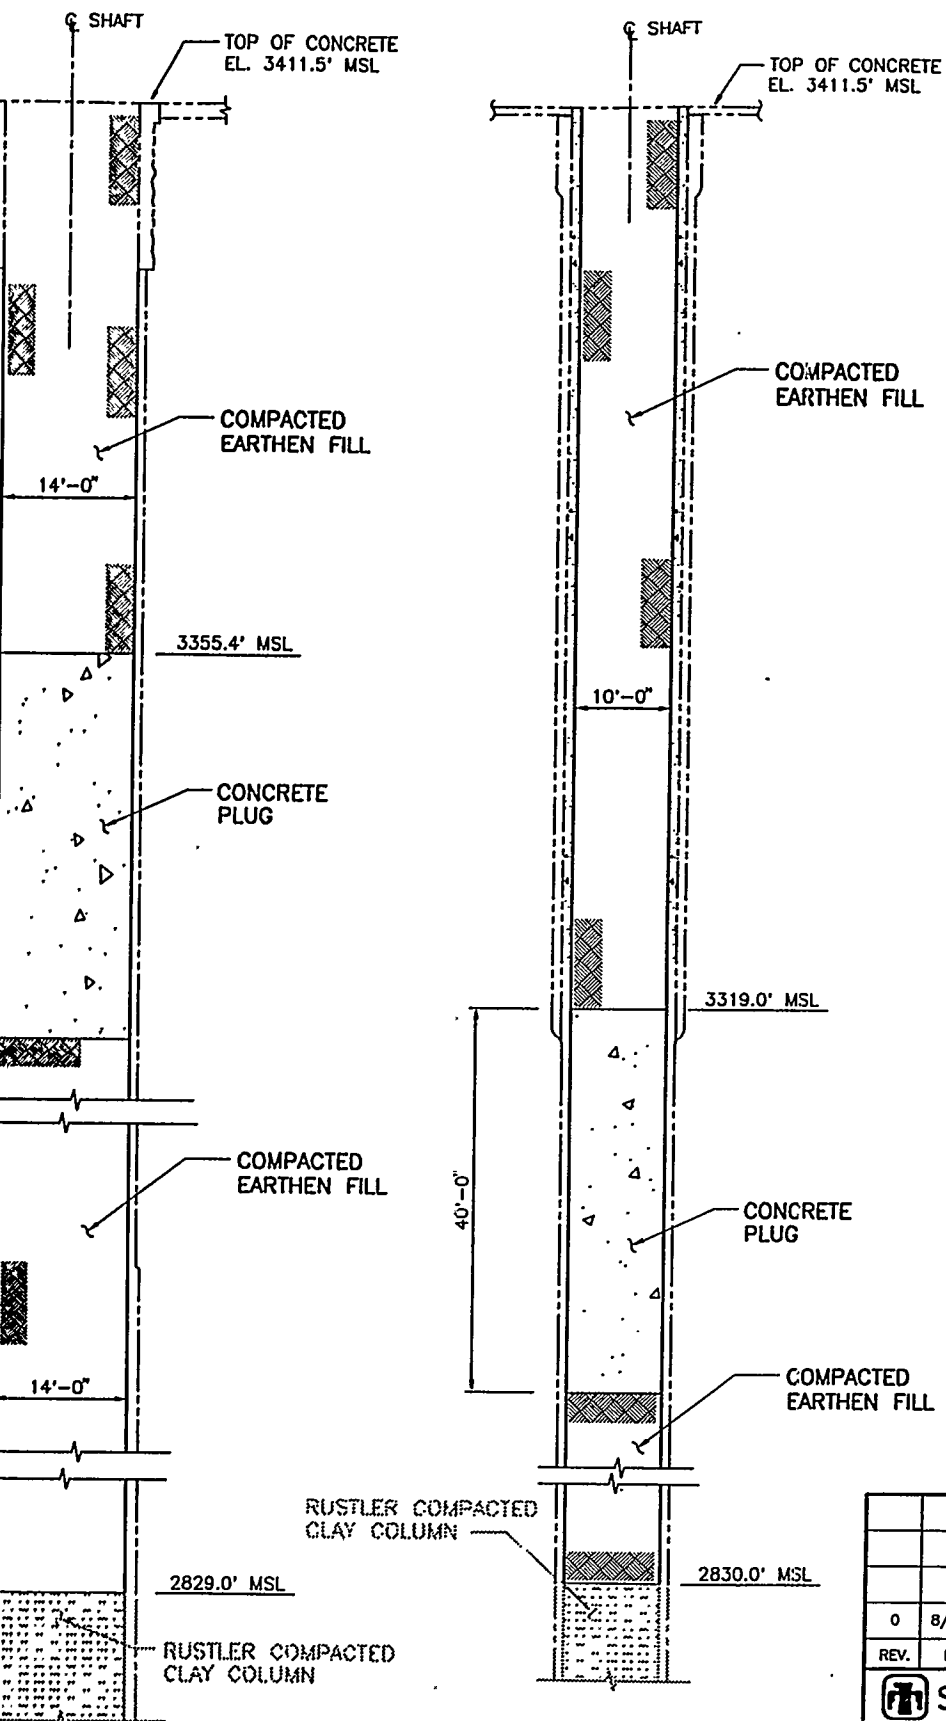

Albert W. Dennis
4-2-96


AIL
SHAFT SHT. 14 SHT. 28

DETAIL
SALT HANDLING SHAFT SHT. 19 SHT. 28

SCALE IN FEET
0 5 10 15 20 25


0	8/2/96	ISSUED FOR RECORDS PACKAGE	BY	CK.	APP
REV.	DATE	DESCRIPTION	BY	CK.	APP
SANDIA NATIONAL LABORATORIES					
WIPP A/E SUPPORT			CONTRACT NO: AG-4909		
WIPP SHAFT SEALING SYSTEM			NAME		
COMPACTED EARTHEN FILL AND CONCRETE PLUG			DATE		
			BY		
			CK.		
			APP		
			APP		
			APP		
PARSONS BRINCKERHOFF ENERGY SERVICES, INC			SCALE:	SIZE B	SNL DWG. NO. SNL-007
			SHEET NO. 28 OF 28		

E-31

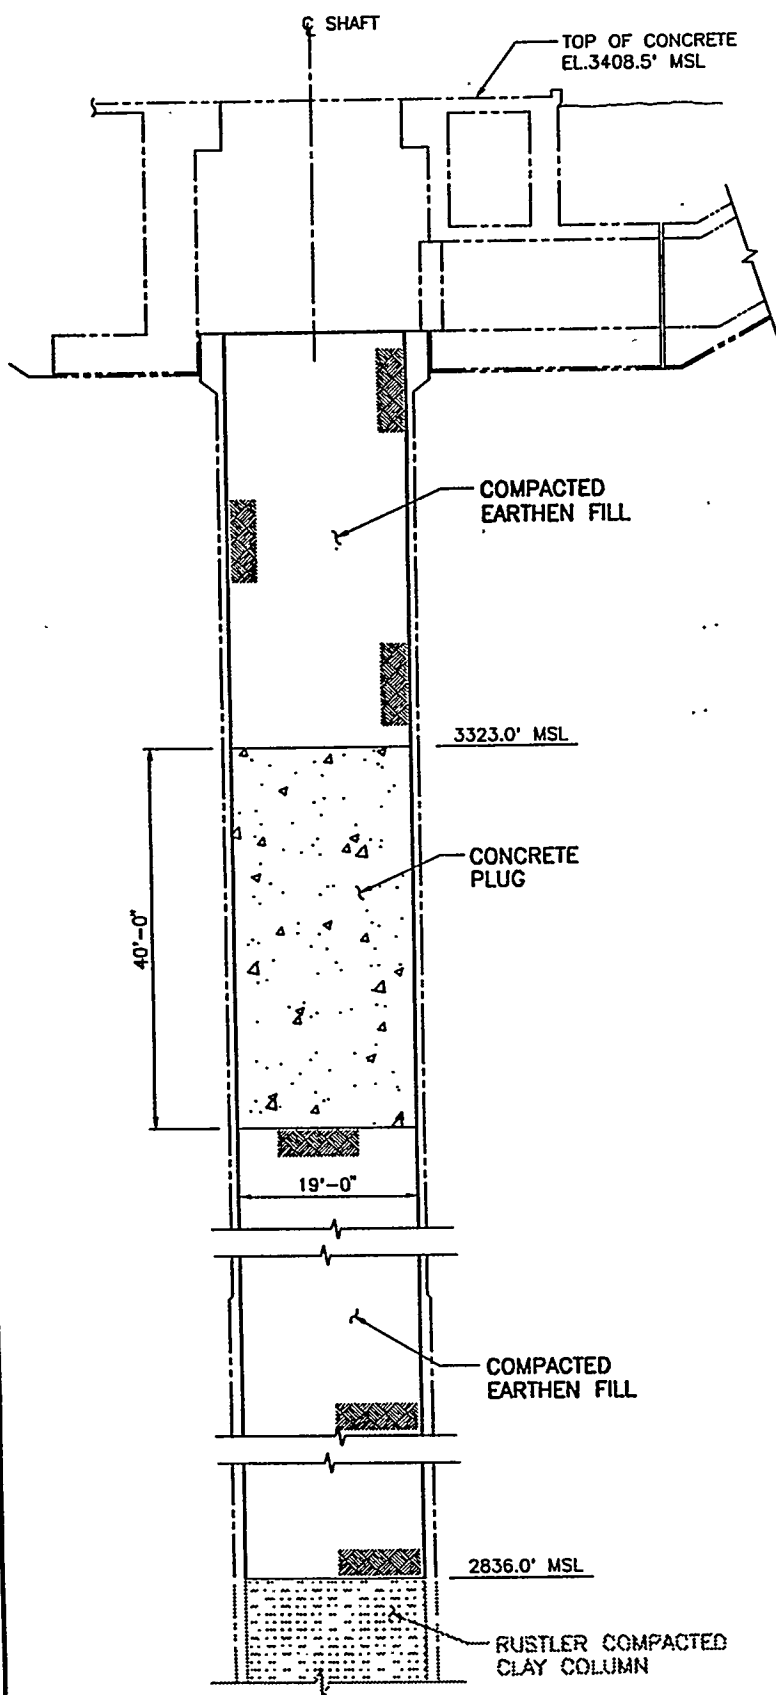

DETAIL
WASTE SHAFT

1
SHT. 4 | SHT. 28

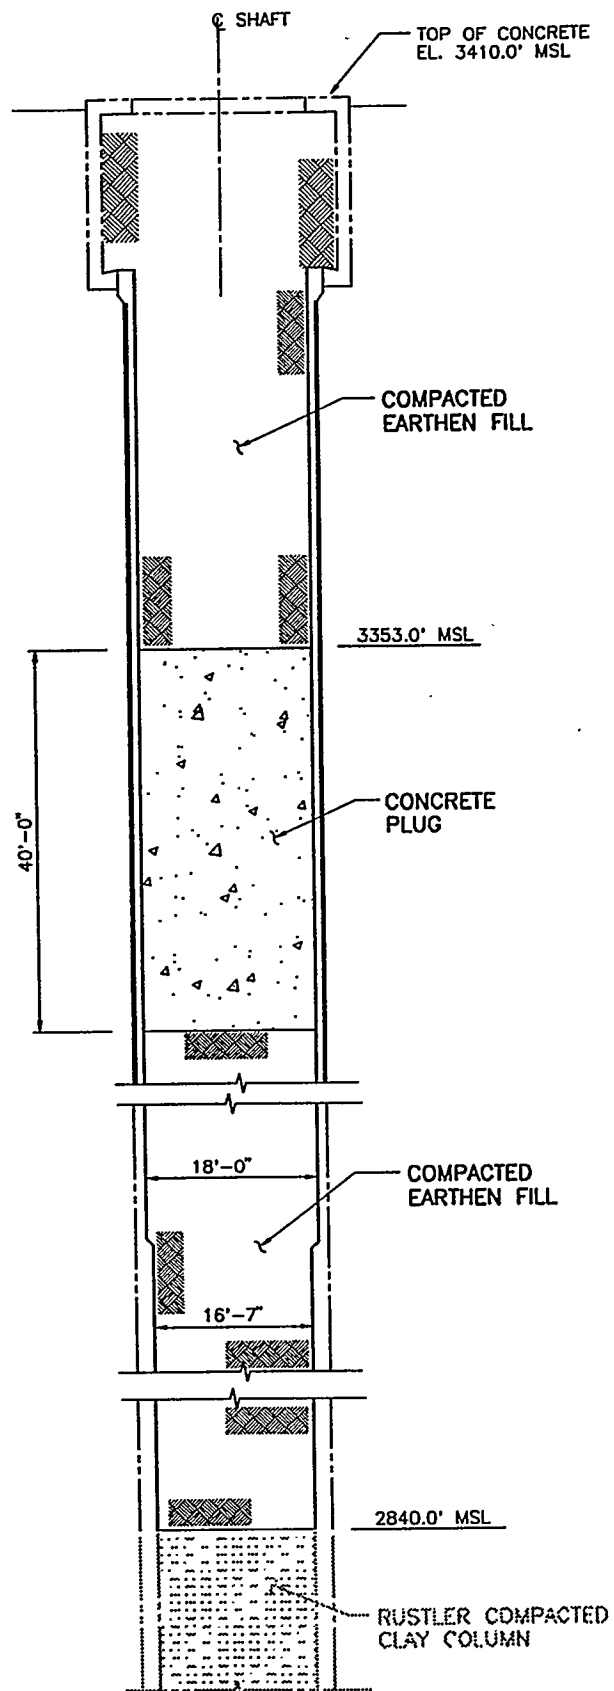

DETAIL
AIR INTAKE SHAFT

2
SHT. 9 | SHT. 28

D E
EXHAU

LOT PLANT

M

TEM DESIGN

UCTION SKETCHES

E-32

SYSTEM
GENERAL
AND SECTIONS

SYSTEM
GENERAL
AND SECTIONS

SYSTEM

SYSTEM
NAME AND
FACILITIES

WASTE ISOLATION
CARLSBAD
SHAFT SEALING S
EQUIPMENT AND CONS'

DRAWING NUMBER

TITLE

SKETCH E-1

WIPP SHAFT SEALIN
SMALLER GALLOWAY
ARRANGEMENT PLA

SKETCH E-2


WIPP SHAFT SEALIN
LARGER GALLOWAY
ARRANGEMENT PLA

SKETCH E-3

WIPP SHAFT SEALIN
TYPICAL HEADFRAM
PLANS AND SECTION

SKETCH E-4

WIPP SHAFT SEALIN
PERSPECTIVE HEAD
ASSOCIATED SURFA

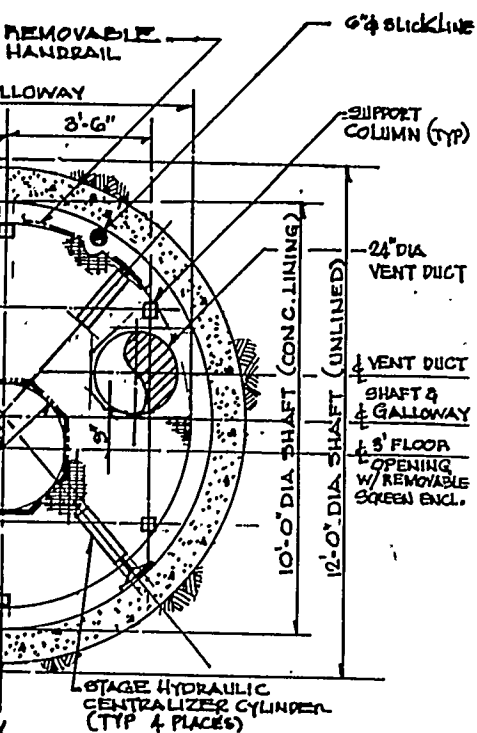


MIDDLE DECK

A SHAFT

5 4 3 2 1 0
FEET

EXPANDED METAL GRATING (TYP)


ACCESS LAMER FROM MIDDLE DECK

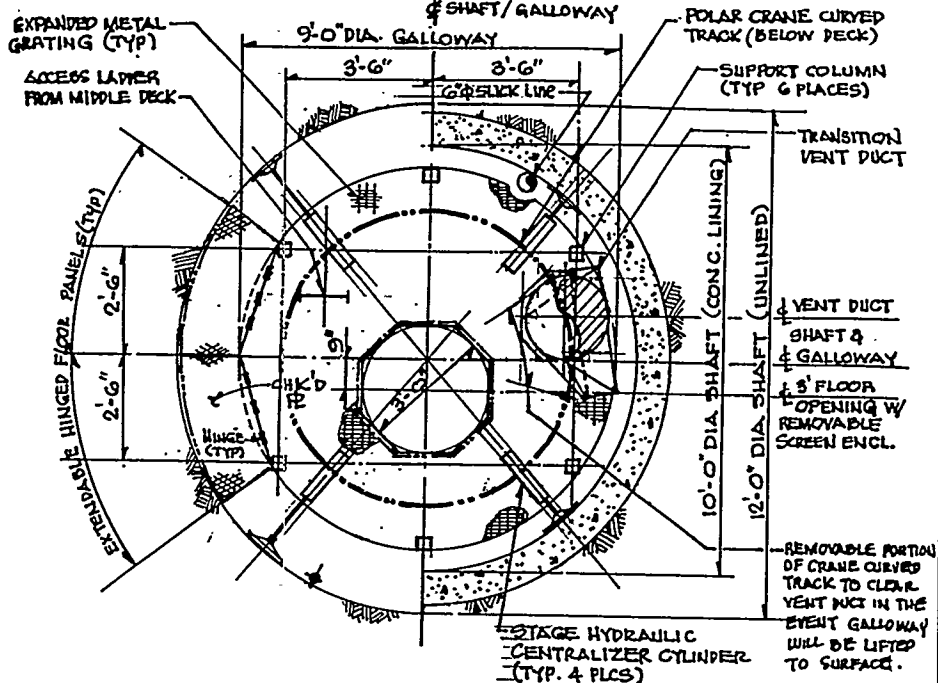


PLAN - BOTTOM DECK

10 FT DIA SHAFT

5 4 3 2 1 0
SCALE IN FEET

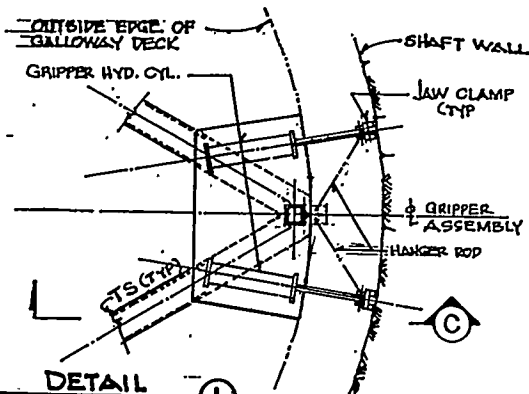


GALLOWAY GRIPPER

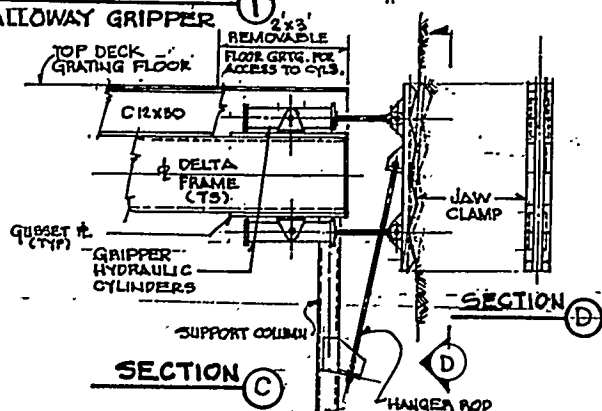

WIPP SHAFT SEALING SYSTEM


SMALLER GALLOWAY
GENERAL ARRANGEMENT
PLANS & SECTIONS

SKETCH E-1

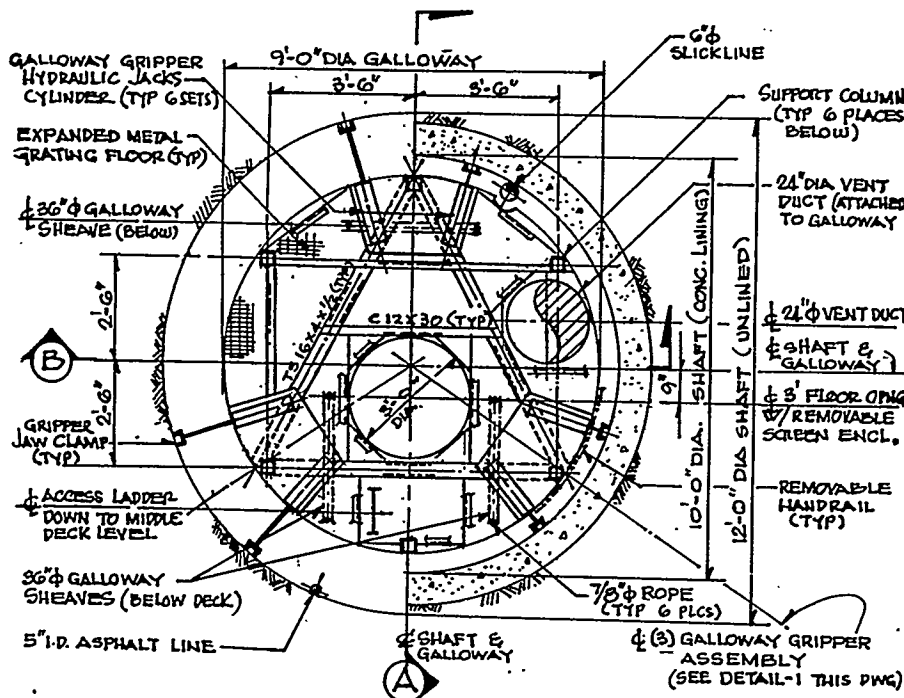


PLAN - TOP DECK

10 FT DIA SHAFT
0 1 2 3 4 5 SCALE IN FEET

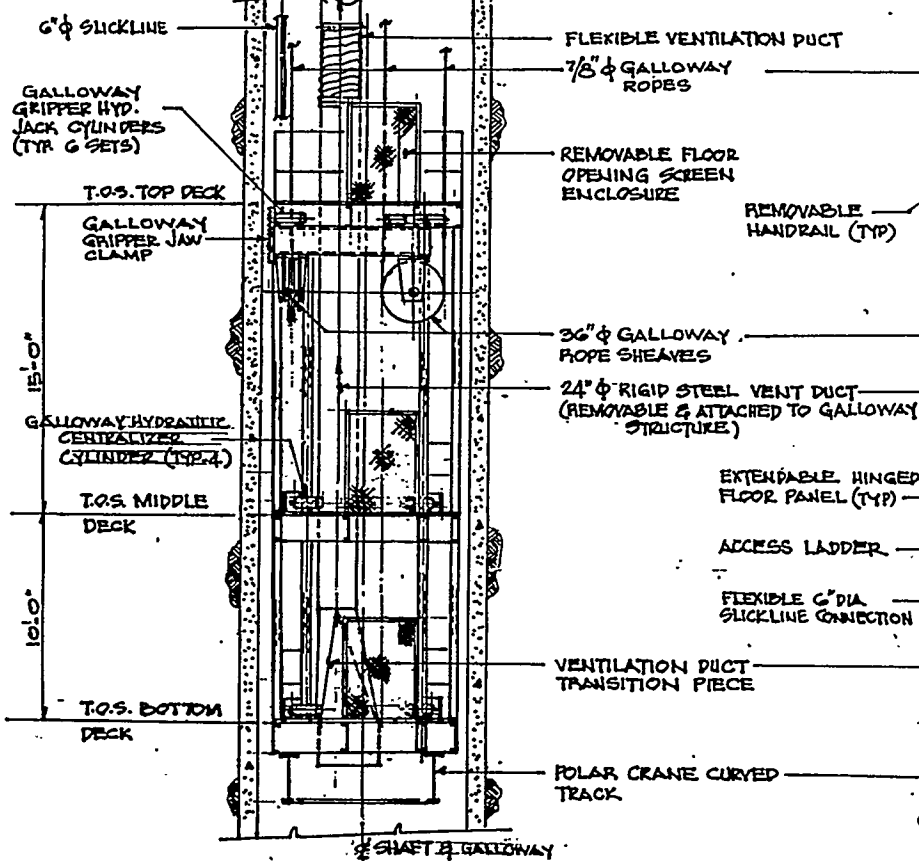


SECTION A

0 1 2 3 4 5 SCALE IN FEET

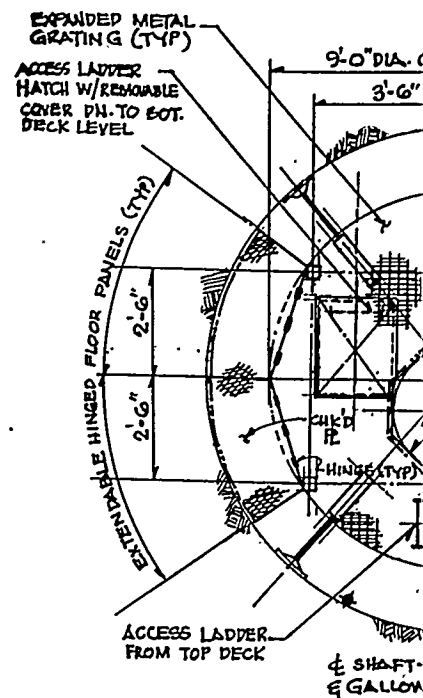



PLAN - MIDDLE DECK

10 FT
0 1 2 3 4 5 SCALE IN FEET

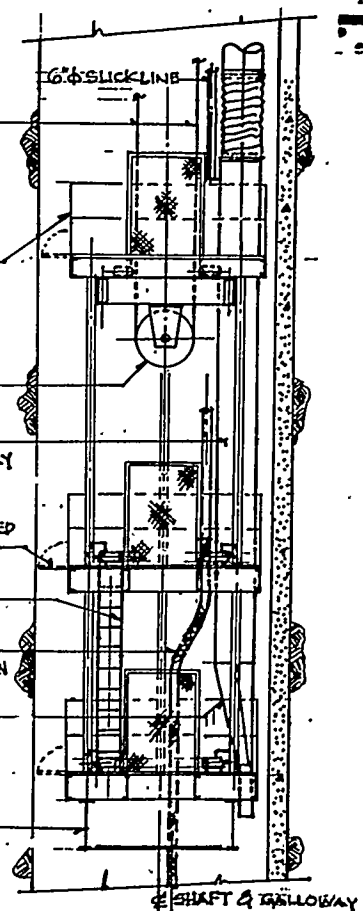

SECTION B


0 1 2 3 4 5 SCALE IN FEET

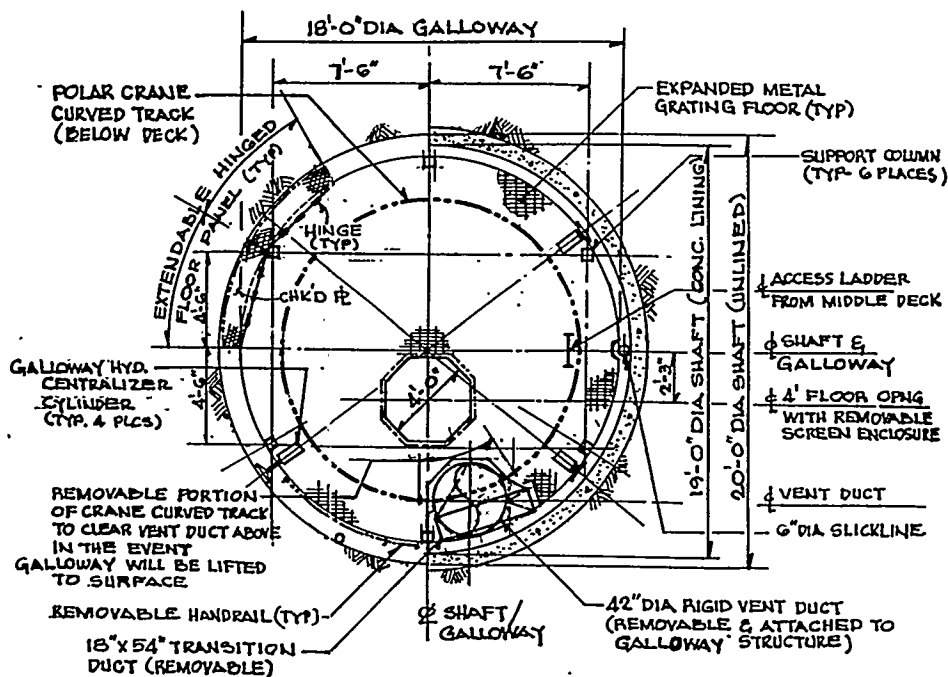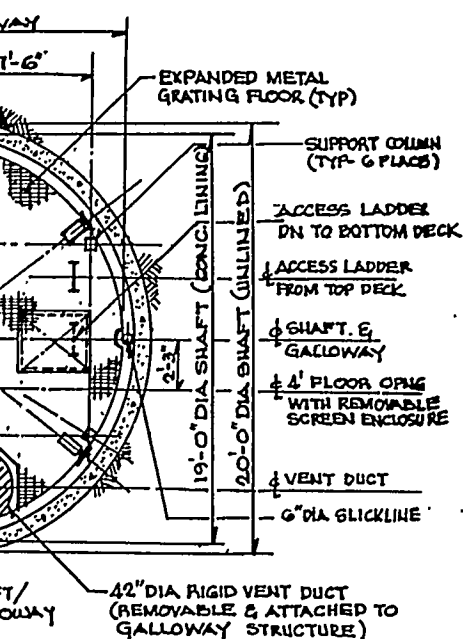

DECK

PLAN - BOTTOM DECK

20 FT DIA SHAFT

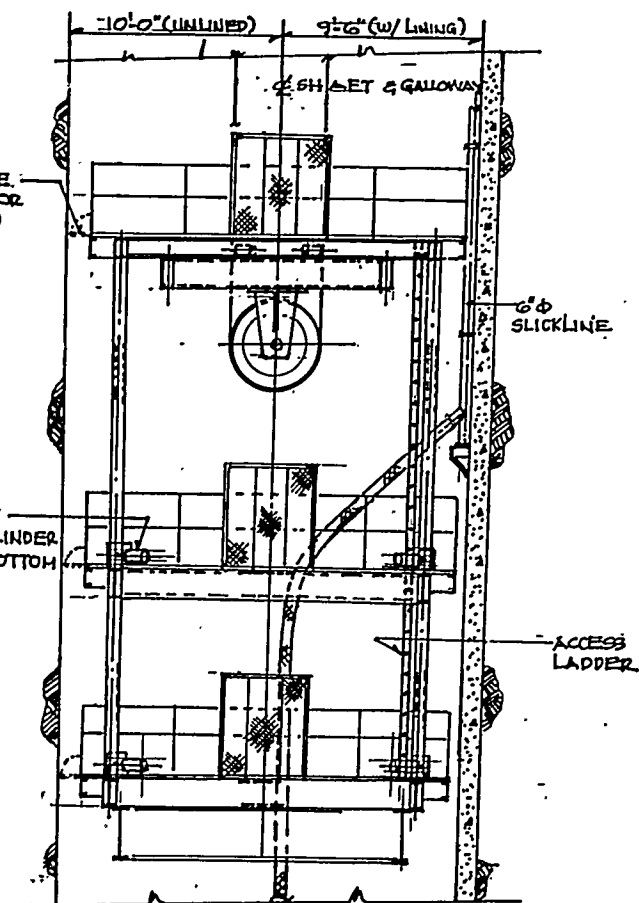

SECTION B


SCALE IN FEET
0 1 2 3 4 5 6

GALLOWAY DESIGN DATA				
	SALT HANDLING SHAFT	EXHAUST SHAFT	AIR INTAKE SHAFT	WASTE SHAFT
Shaft Diameter	10'-0" (lined) 11'-10" (unlined)	14' (lined) 15' (unlined)	16'-7" (lined) 20' (unlined)	19'-0" (lined) 20' (unlined)
Dia of Galloway	9ft	13ft	15'-7"	18ft
Height of Galloway	25ft	25ft	26ft	26ft
Dia of Vent duct	24 inch	36 inch	42 inch	42 inch
No. of Galloway rope	6	6	6	6
No. of Galloway sheave	3	3	3	3
Dia of Galloway rope	7/8 inch	1 1/8 inch	1 1/4 inch	1 1/4 inch
Dia of Galloway sheaves	36 inch	36 inch	54 inch	54 inch
Wt. of Galloway (struct)	18000 lb	29000 lb	40200 lb	49600 lb
Polar crane wt.	38696 lb	48606 lb	58696 lb	58696 lb
Tamper weight	11394 lb	11394 lb	11394 lb	11394 lb
Total Wt. Galloway (live and dead load)	80409 lb	113816 lb	143622 lb	162622 lb


WIPP SHAFT SEALING SYSTEM

LARGER GALLOWAY
GENERAL ARRANGEMENT
PLANS & SECTIONS


SKETCH E-2

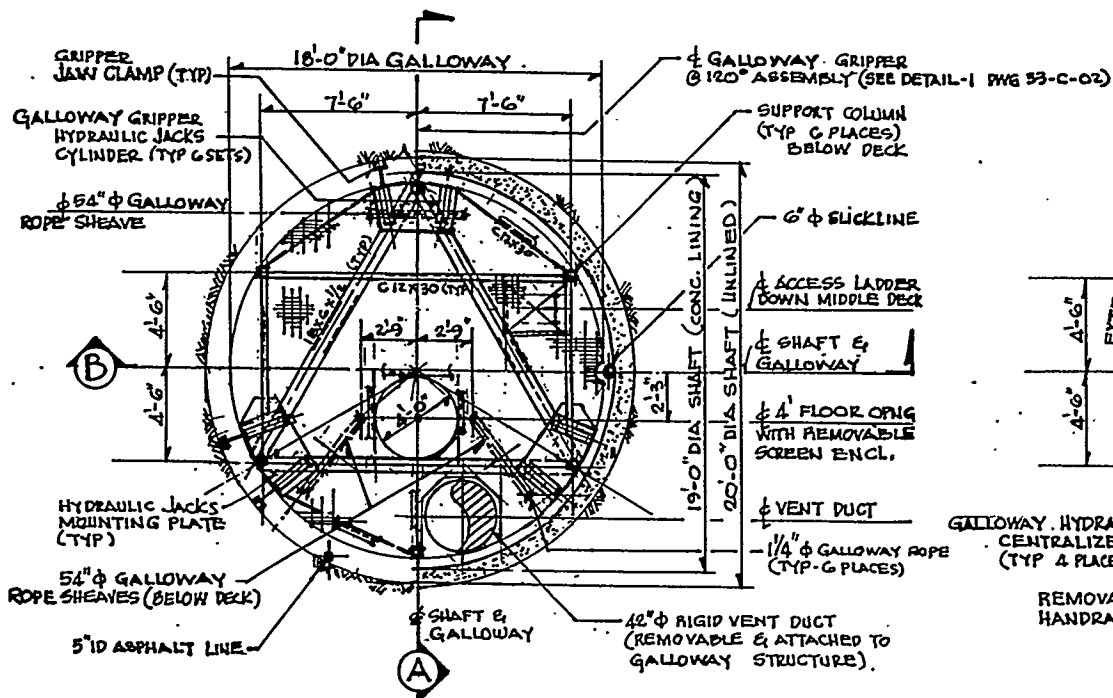


PLAN - TOP DECK
20 FT DIA SHAFT

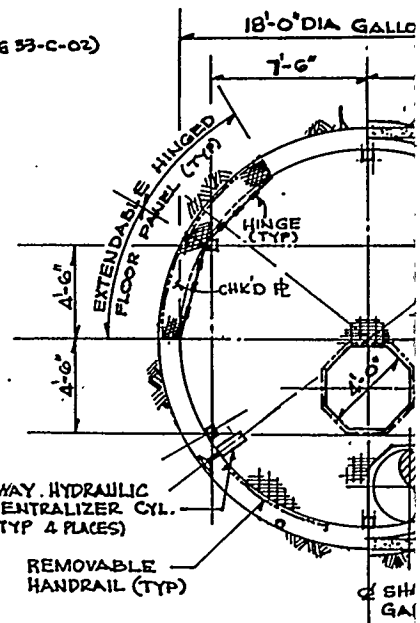


PLAN - MIDDLE DECK
20 FT DIA SHAFT

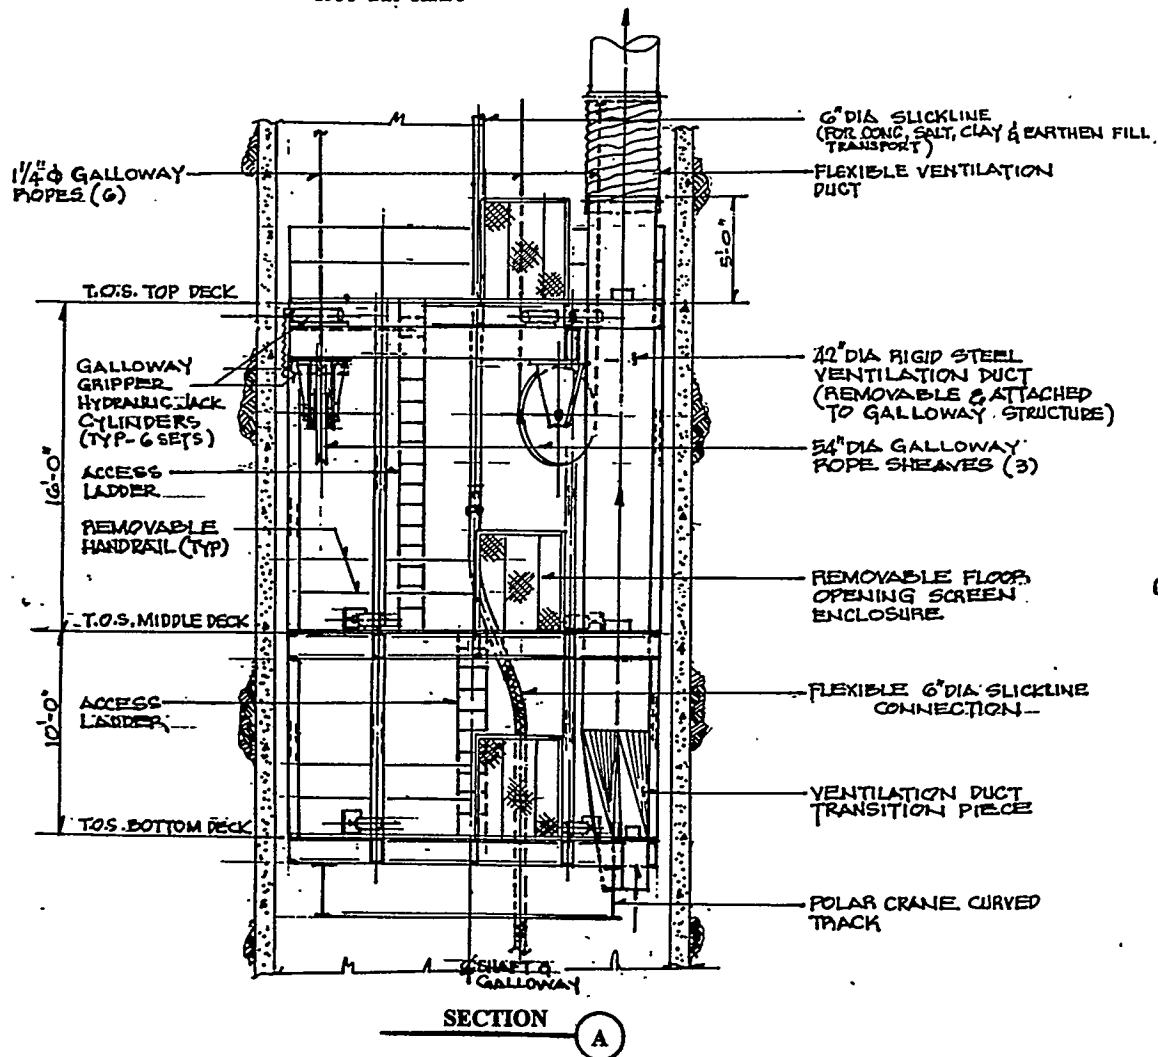

SECTION A

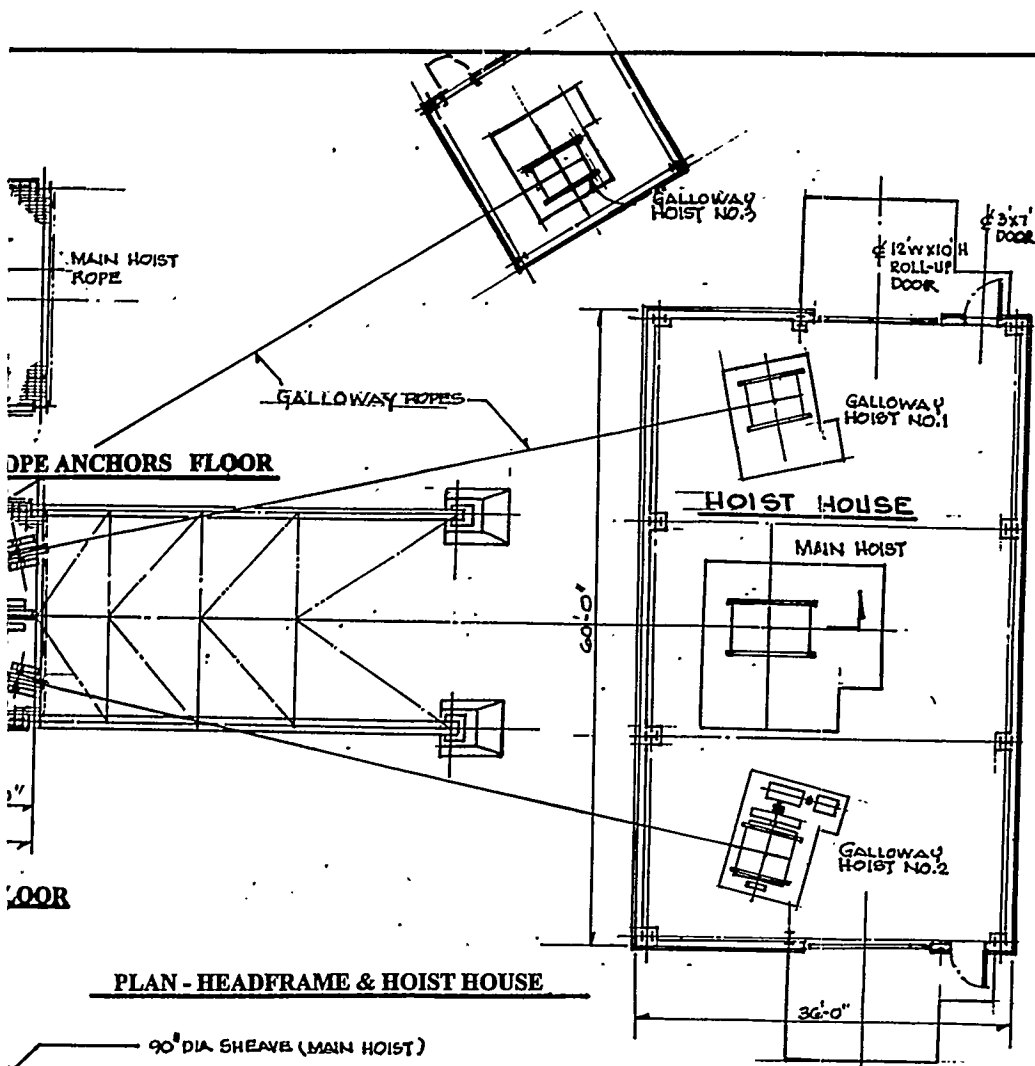


PLAN - HEADFRAME & HOIST HOUSE

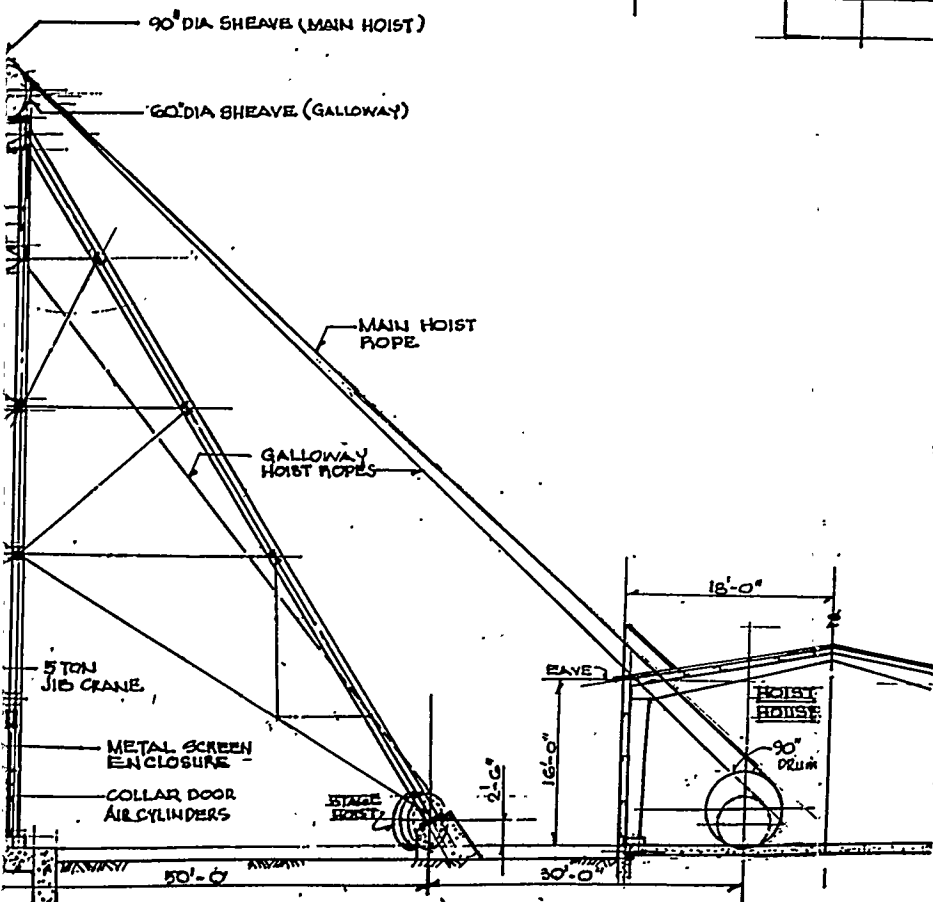


SCALE IN FEET
0 2 4 6 8 10

WIPP SHAFT SEALING SYSTEM


TYPICAL HEADFRAME
PLANS & SECTIONS
SKETCH E-3

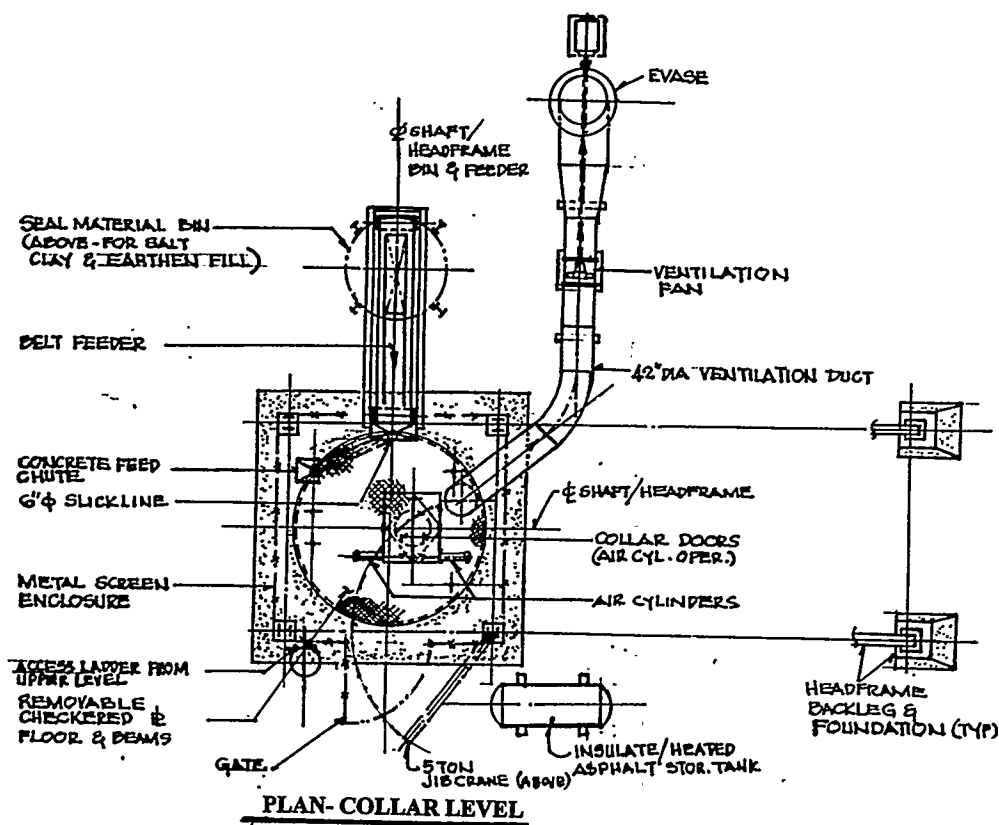


PLAN-COLLAR LEVEL

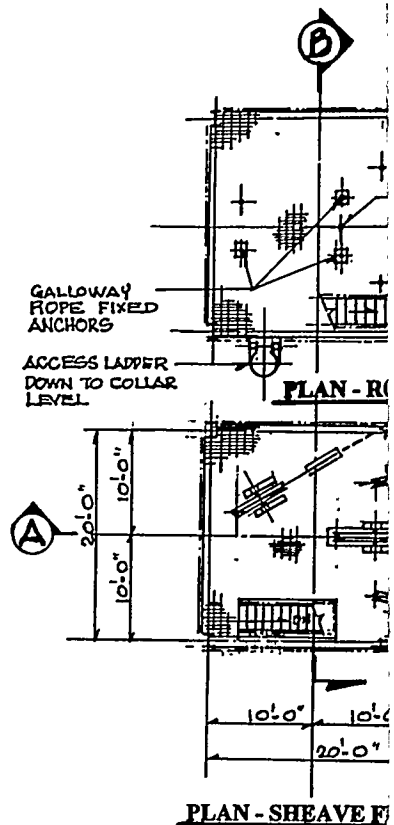


PLAN-SHEAVE FLOOR

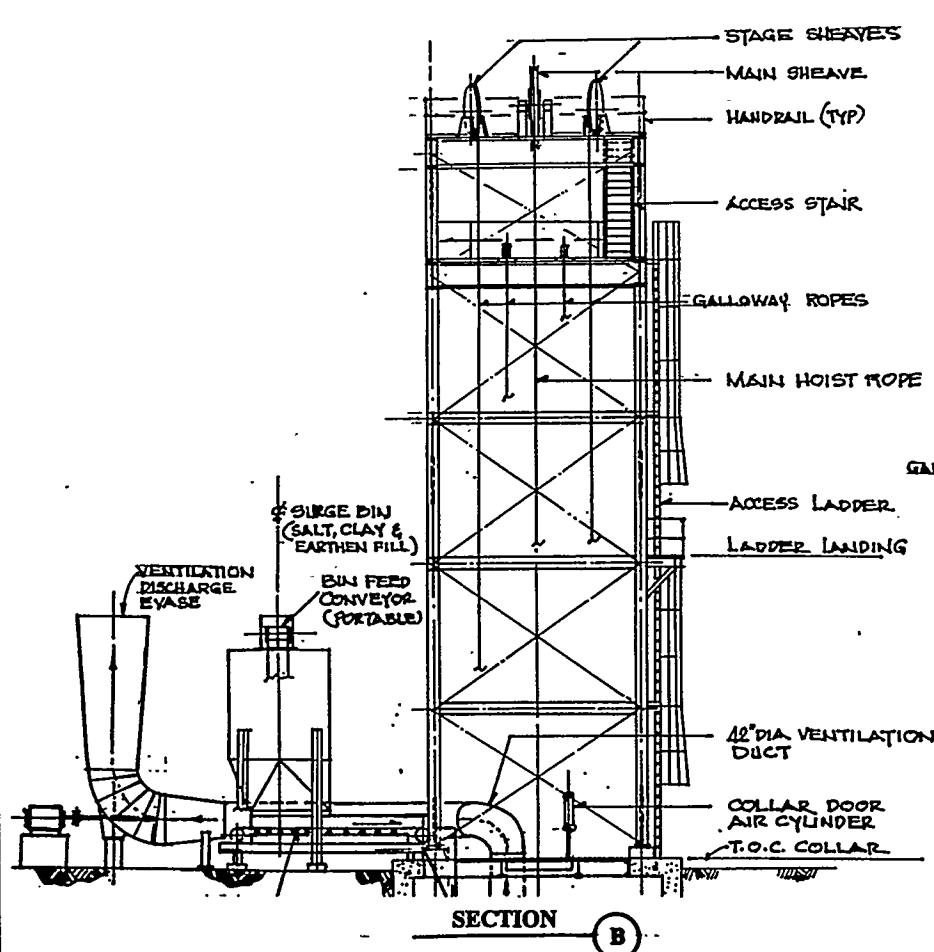

SECTION B

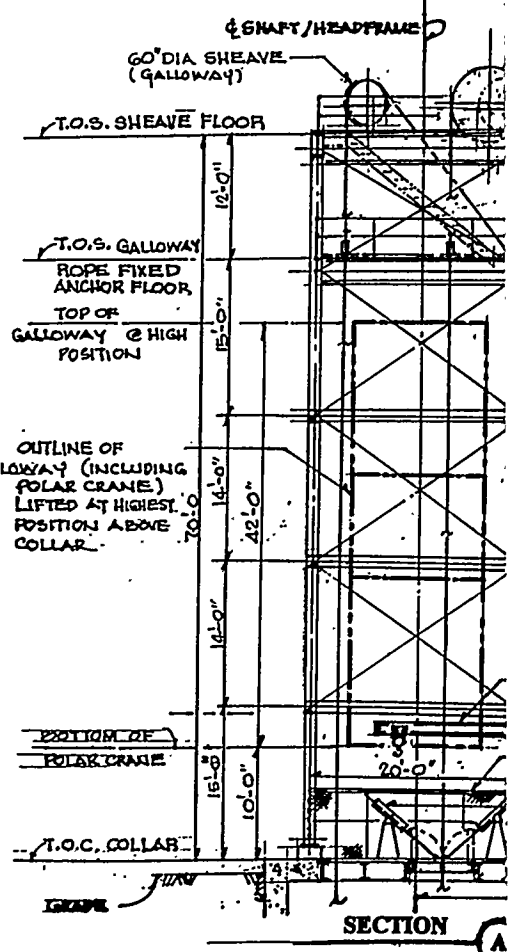

SECTION A

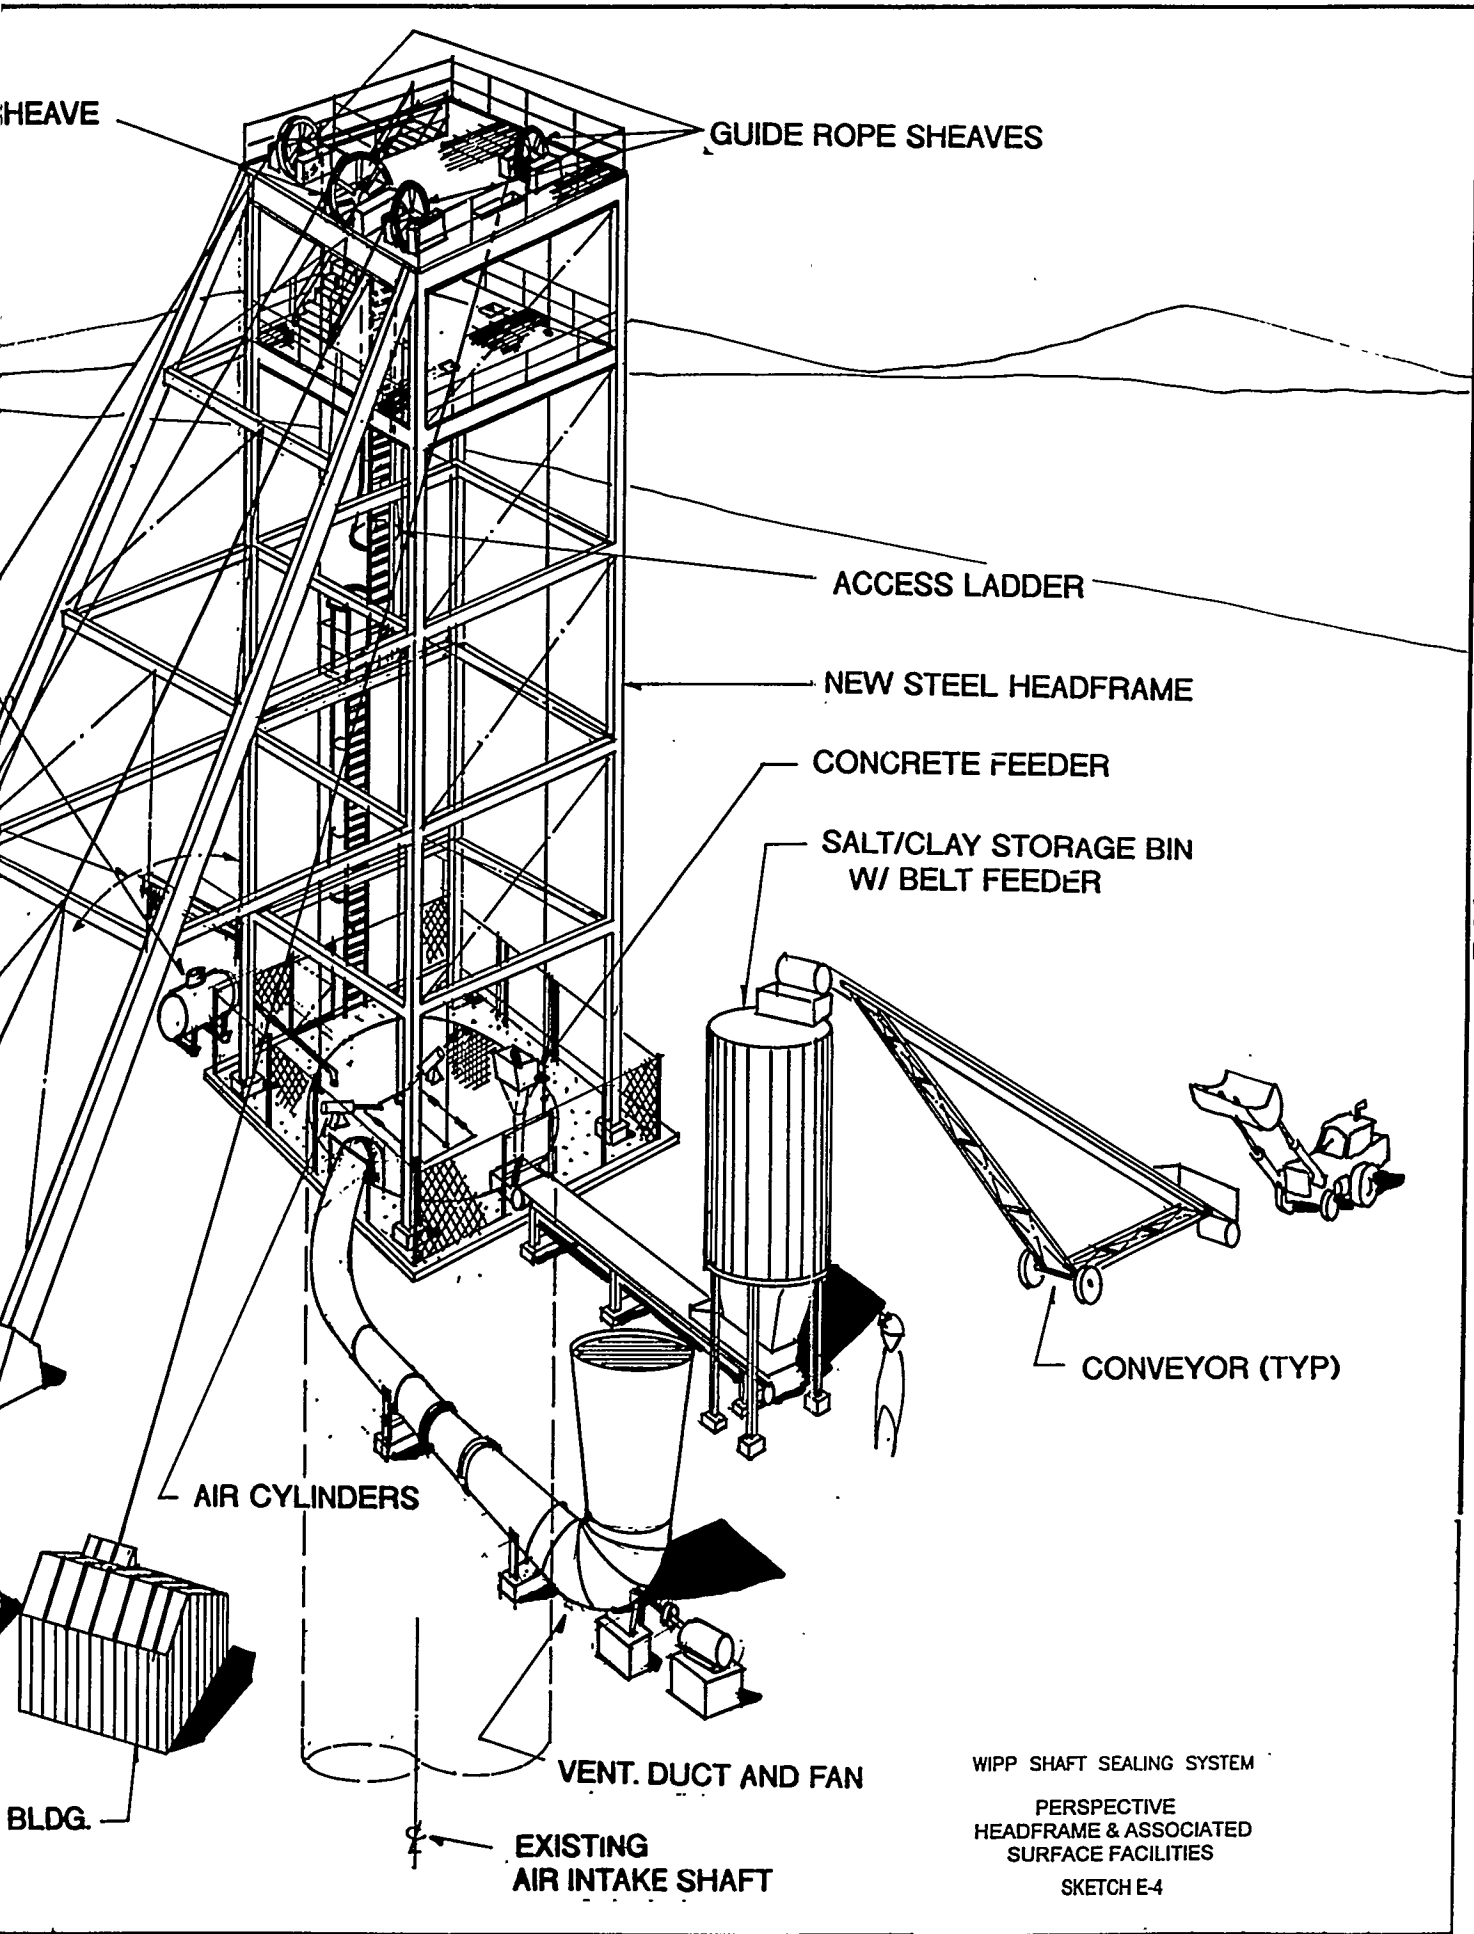

E-36

WIPP SHAFT SEALING SYSTEM
PERSPECTIVE
HEADFRAME & ASSOCIATED
SURFACE FACILITIES
SKETCH E-4

MAIN S

PORTABLE PRIMARY
SALT CRUSHING PLANT

SALT STORAGE

PORTABLE OMNICONIC
CRUSHING PLANT

CRUSHED/SCREEN
SALT STORAGE

INSULATED/HEATED
ASPHALT
STORAGE TANK

5 TON
JIB CRANE

SAND

GRAVEL

FLYASH


CEMENT

GRAVEL

SAND

GALLOWAY AND
MAIN HOIST BLDG.

GALLOWAY HOIST

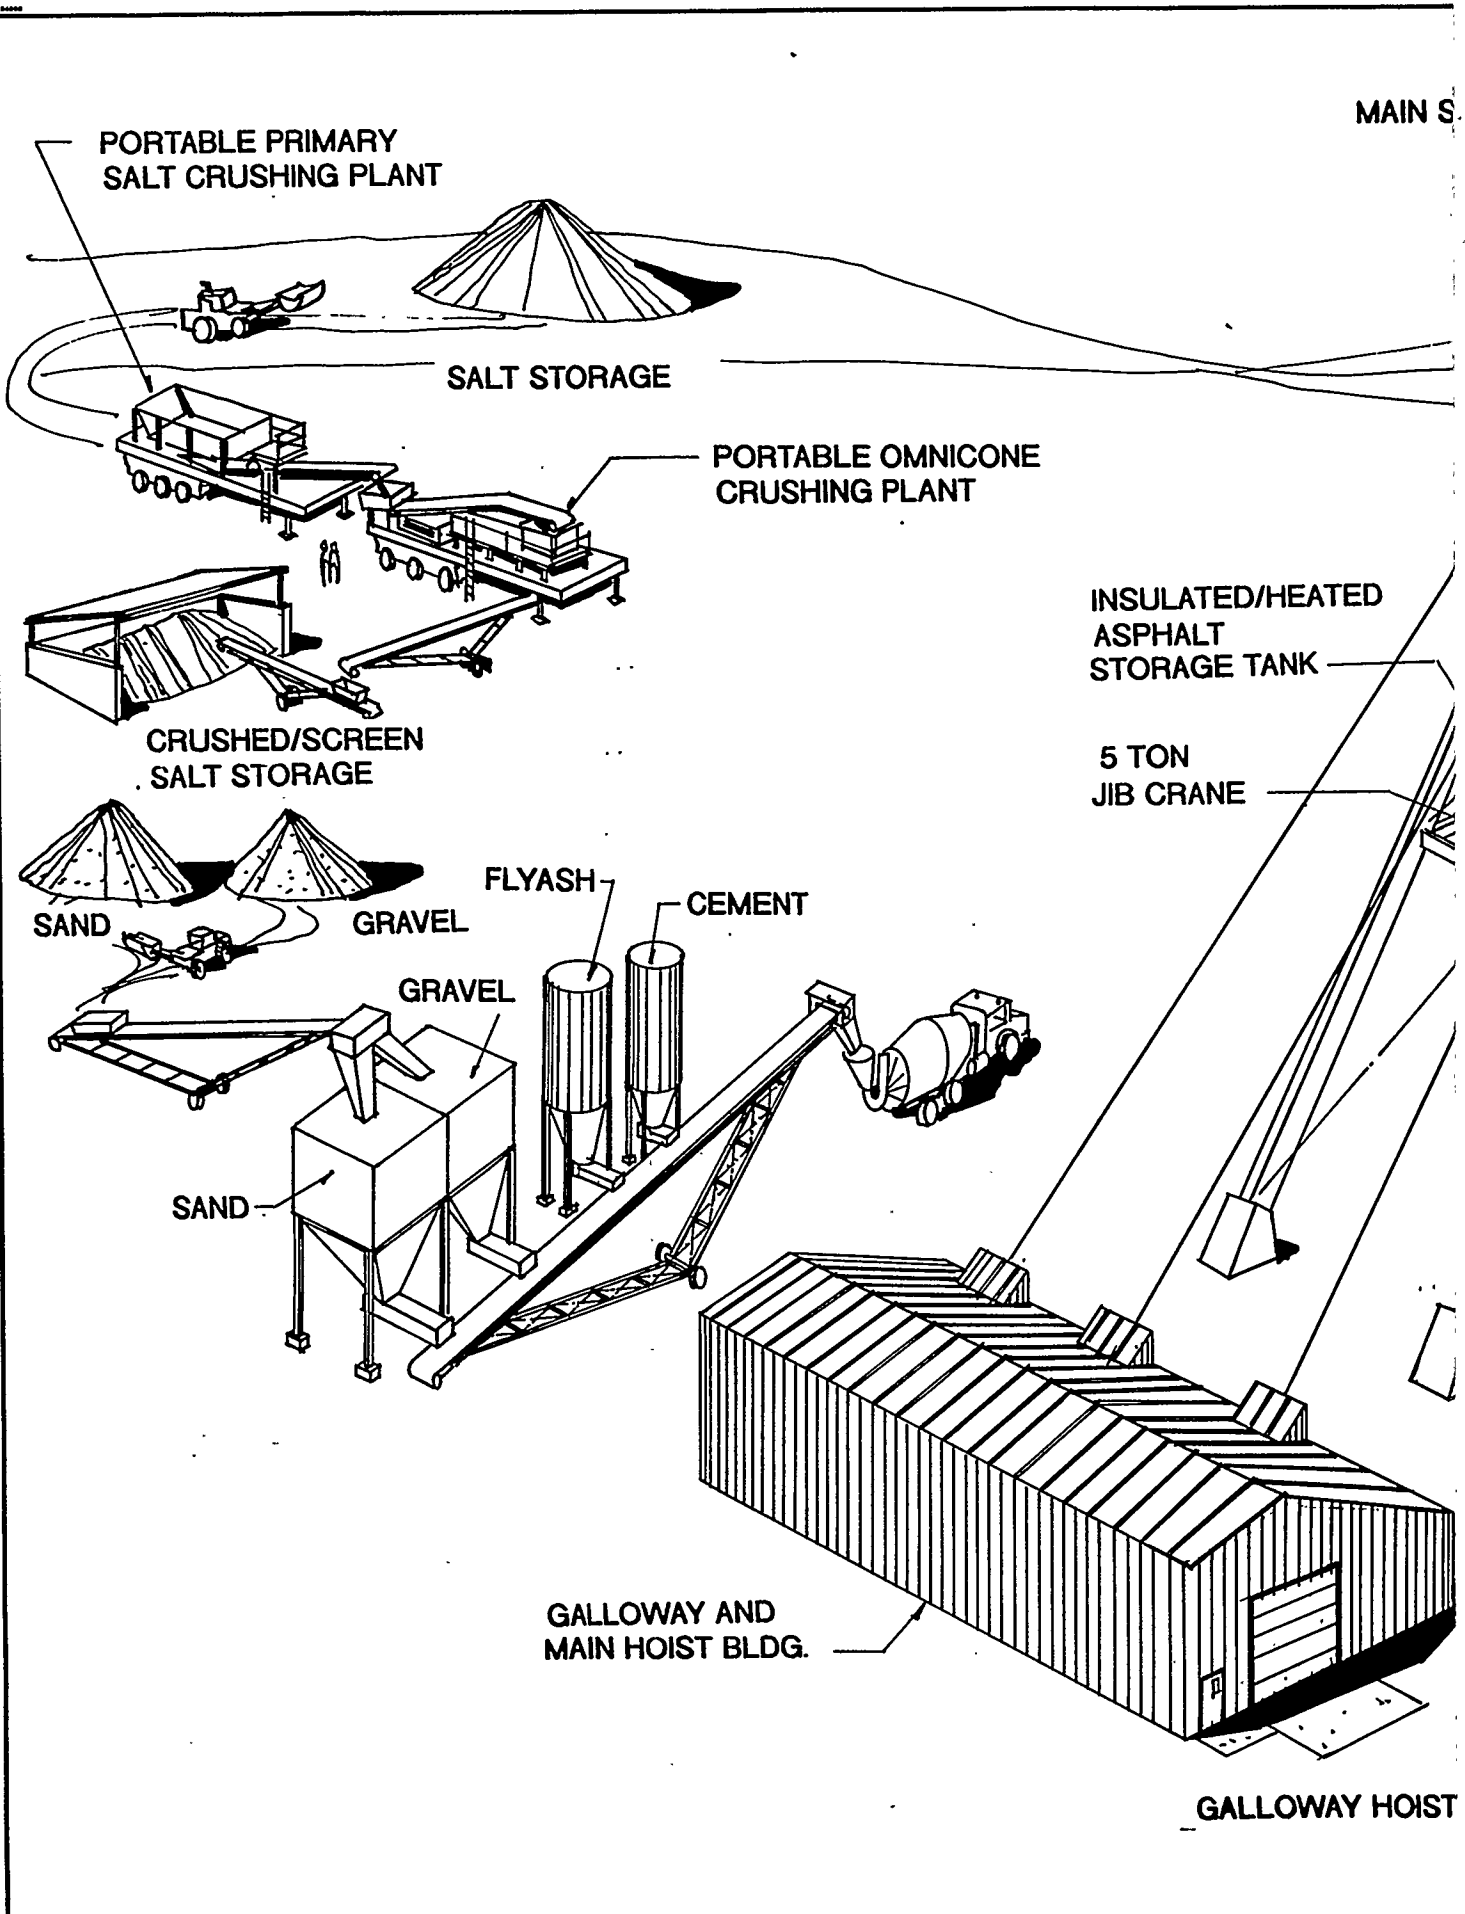

Environmental Evaluation Group (3)
Attn: Library
7007 Wyoming NE, Suite F-2
Albuquerque, NM 87109

Metropolitan Water District of Southern Calif.
Attn: J. Narvaiz
P.O. Box 54153
Los Angeles, CA 90071-3123

NM Energy, Minerals, and Natural
Resources Department
Attn: Library
2040 S. Pacheco
Santa Fe, NM 87505

NM Environment Department (3)
Secretary of the Environment
Attn: Mark Weidler
1190 St. Francis Drive
Santa Fe, NM 87503-0968

NM Bureau of Mines & Mineral Resources
Socorro, NM 87801

NM Environment Department
WIPP Project Site
Attn: P. McCasland
P.O. Box 3090
Carlsbad, NM 88221

Laboratories/Corporations

Battelle Pacific Northwest Laboratories (2)
Attn: R. E. Westerman
R. Romine, MS P8-38
P.O. Box 999
900 Battelle Blvd.
Richland, WA 99352

Brookhaven National Laboratory
Attn: P. D. Moskowitz
Environmental & Waste Technology
Center
Building 830
Upton, NY 11973

Harnischfeger Corp.
Phonex Engineering Services
Attn: R. Luebke
2969 S. Chase Avenue
Milwaukee, WI 53207-6408

Ian Clelland
6656 N. Amdahl Dr.
Tucson, AZ 85704

INTERA, Inc.
Attn: G. A. Freeze
1650 University Blvd. NE, Suite 300
Albuquerque, NM 87102

INTERA, Inc. (6)
Attn: J. F. Pickens
V. Kelley
M. Reeves
W. Statham
J. Beach
D. Fryar
INTERA WIPP Library
6850 Austin Center Blvd., Suite 300
Austin, TX 78731

INTERA, Inc.
Attn: J. Lee, YMP PA Dept.
1261 Town Center Drive
Las Vegas, NV 89134

INTERA, Inc.
Attn: W. Stensrud
P.O. Box 2123
Carlsbad, NM 88221

Istasca Consulting Group, Inc.
Attn: John Tinucci
Thresher Square East
708 South Third Street, Suite 310
Minneapolis, MI 55415

Los Alamos National Laboratory
Attn: B. Erdal, INC-12
P.O. Box 1663
Los Alamos, NM 87544

Morton International, Morton Salt
Attn: H. W. Diamond
Morton International Building
100 N. Riverside Plaza,
Randolph Street at the River
Chicago, IL 60606-1597

Parsons Brinckerhoff Energy Services, Inc.
Attn: W. S. Roman
One Penn Plaza
New York, NY 10119

Parsons Brinckerhoff Energy Services, Inc. (2)
Attn: B. W. Lawerance
C. D. Mann
M. S. Lin
303 Second Street
Suite 850 North
San Francisco, CA 94107

**WIPP
UC721 Distribution List**

Federal Agencies

US Department of Energy (4)
Office of Civilian Radioactive Waste Mgmt.
Attn: Deputy Director, RW-2
Acting Director, RW-10
Office of Human Resources & Admin.
Director, RW-30
Office of Program Mgmt. & Integ.
Director, RW-40
Office of Waste Accept., Stor., & Tran.
Forrestal Building
Washington, DC 20585

Attn: Project Director (2)
Yucca Mountain Site Characterization Office
Director, RW-3
Office of Quality Assurance
101 Convention Center Drive, Suite #P-110
Las Vegas, NV 89109

US Department of Energy
Albuquerque Operations Office
Attn: National Atomic Museum Library
P.O. Box 5400
Albuquerque, NM 87185-5400

US Department of Energy
Research & Waste Management Division
Attn: Director
P.O. Box E
Oak Ridge, TN 37831

US Department of Energy (8)
Carlsbad Area Office
Attn: G. Dials
D. Galbraith (3)
M. Matthews
M. McFadden
R. Lark
J. A. Mewhinney
P.O. Box 3090
Carlsbad, NM 88221-3090

US Department of Energy
Office of Environmental Restoration and
Waste Management
Attn: J. Lytle, EM-30
Forrestal Building
Washington, DC 20585-0002

US Department of Energy (3)
Office of Environmental Restoration and
Waste Management
Attn: M. Frei, EM-34, Trevion II
Washington, DC 20585-0002

US Department of Energy
Office of Environmental Restoration and
Waste Management
Attn: S. Schneider, EM-342, Trevion II
Washington, DC 20585-0002

US Department of Energy (2)
Office of Environment, Safety & Health
Attn: C. Borgstrom, EH-25
R. Pelletier, EH-231
Washington, DC 20585

US Department of Energy (2)
Idaho Operations Office
Fuel Processing & Waste Mgmt. Division
785 DOE Place
Idaho Falls, ID 83402

US Environmental Protection Agency (2)
Radiation Protection Programs
Attn: M. Oge
ANR-460
Washington, DC 20460

Boards

Defense Nuclear Facilities Safety Board
Attn: D. Winters
625 Indiana Ave. NW, Suite 700
Washington, DC 20004

Nuclear Waste Technical Review Board (2)
Attn: Chairman
S. J. S. Parry
1100 Wilson Blvd., Suite 910
Arlington, VA 22209-2297

State Agencies

Attorney General of New Mexico
P.O. Drawer 1508
Santa Fe, NM 87504-1508

Della Roy
Pennsylvania State University
217 Materials Research Lab
Hastings Road
University Park, PA 16802

David A. Waite
CH₂ M Hill
P.O. Box 91500
Bellevue, WA 98009-2050

Thomas A. Zordon
Zordan Associates, Inc.
3807 Edinburg Drive
Murrysville, PA 15668

Universities

Harvey Mudd College
Attn: M. Cardenas
Department of Engineering
Claremont, CA 91711

New Mexico State University
Waste-management Education & Research
Corporation.
Attn: R. Bhada
P.O. Box 3001
Las Cruces, NM 88003-8001

University of California
Department of Mechanical and Environmental
Engineering
Attn: E. Marschall
University of California
Santa Barbara, CA 93106

University of Nevada-Reno
Department of Mining Engineering
Mackay School of Mines
Attn: J. Daamen
Reno, NV 89557

University of New Mexico
Center for Radioactive Waste Management
Attn: W. Lutze
209 Faris Engineering Building
Albuquerque, NM 87131-1341

University of New Mexico
Department of Civil Engineering
Attn: J. C. Stormont
Albuquerque, NM 87131-1351

University of New Mexico
Geology Department
Attn: Library
141 Northrop Hall
Albuquerque, NM 87131

University of Washington
College of Ocean & Fishery Sciences
Attn: G. R. Heath
583 Henderson Hall, HN-15
Seattle, WA 98195

Libraries

Thomas Brannigan Library
Attn: D. Dresp
106 W. Hadley St.
Las Cruces, NM 88001

Government Publications Department
Zimmerman Library
University of New Mexico
Albuquerque, NM 87131

New Mexico Junior College
Pannell Library
Attn: R. Hill
Lovington Highway
Hobbs, NM 88240

New Mexico State Library
Attn: N. McCallan
325 Don Gaspar
Santa Fe, NM 87503

New Mexico Tech
Martin Speere Memorial Library
Campus Street
Socorro, NM 87810

WIPP Public Reading Room
Carlsbad Public Library
101 S. Halagueno St.
Carlsbad, NM 88220

Foreign Addresses

Atomic Energy Canada Ltd. (5)
Whiteshell Laboratory
Attn: Neil Chandler
Glenn McCrank
B. Goodwin
Malcolm Gray
Maria Onefrei
Pinawa Manitoba, CANADA ROE 1L0

Parsons Brinckerhoff International, Inc.
Attn: Mary Ann Novak
700 11th Street, NW, Suite 710
Washington, DC 20001

Phillips Mining, Geotechnical & Grouting
Attn: Stephen Phillips
8640 North Glenhurst Place
Tucson, AZ 85704

RE/SPEC, Inc. (5)
Attn: L. Van Sambeek (3)
G. Callahan
M. Loken
J. Ratigan
T. Pfeifle
3824 Jet Drive
P.O. Box 725
Rapid City, SD 57709

RE/SPEC, Inc
Attn: Angus Robb
4775 Indian School NE, Suite 300
Albuquerque, NM 87110-3927

Science Applications International Corp.
Attn: W. Thompson
15000 W. 6th Avenue, Suite 202
Golden, CO 80401

Tech Reps, Inc. (3)
Attn: J. Chapman (1)
L. Robledo (2)
5000 Marble NE, Suite 222
Albuquerque, NM 87110

Westinghouse Electric Corporation (5)
Attn: Library
J. Epstein
J. Lee
B. A. Howard
R. Kehrman
P.O. Box 2078
Carlsbad, NM 88221

S. Cohen & Associates
Attn: Bill Thurber
1355 Beverly Road
McLean, VA 22101

**National Academy of Sciences,
WIPP Panel**

Howard Adler
Oxyrase, Incorporated
7327 Oak Ridge Highway
Knoxville, TN 37931

Bob Andrews
Board of Radioactive Waste Management
GF456
2101 Constitution Ave.
Washington, DC 20418

Rodney C. Ewing
Department of Geology
University of New Mexico
Albuquerque, NM 87131

Charles Fairhurst
Department of Civil
and Mineral Engineering
University of Minnesota
500 Pillsbury Dr. SE
Minneapolis, MN 55455-0220

B. John Garrick
PLG Incorporated
4590 MacArthur Blvd., Suite 400
Newport Beach, CA 92660-2027

Leonard F. Konikow
US Geological Survey
431 National Center
Reston, VA 22092

Carl A. Anderson, Director
Board of Radioactive Waste Management
National Research Council
HA 456
2101 Constitution Ave. NW
Washington, DC 20418

Christopher G. Whipple
ICF Kaiser Engineers
1800 Harrison St., 7th Floor
Oakland, CA 94612-3430

John O. Blomeke
720 Clubhouse Way
Knoxville, TN 37909

Sue B. Clark
University of Georgia
Savannah River Ecology Lab
P.O. Drawer E
Aiken, SC 29802

Konrad B. Krauskopf
Department of Geology
Stanford University
Stanford, CA 94305-2115

Internal

<u>MS</u>	<u>Org.</u>	
0483	5165	R. E. Stinebaugh
0706	6113	J. K. Linn
1320	6719	E. J. Nowak
1322	6121	J. R. Tillerson (10)
1322	6121	E. H. Ahrens (2)
1322	6121	A. W. Dennis (10)
1322	6121	F. D. Hansen
1322	6121	L. D. Hurtado
1322	6121	M. K. Knowles
1324	6115	P. B. Davies
1325	6852	L. S. Costin
1325	6852	R. E. Finley
1328	6749	D. R. Anderson
1328	6741	H. N. Jow
1328	6849	M. F. Fewell
1328	6849	P. Vaughn
1335	6705	M. Chu
1341	6748	J. T. Holmes
1395	6800	L. Shephard
1395	6707	M. Marietta
1395	6841	V. H. Slaboszewicz
1330	6752	B. J. Pierson (2)
1330	6752	NWM Library (100)
9018	8523-2	Central Technical Files
0899	4414	Technical Library (5)
0619	12630	Review and Approval Desk, For DOE/OSTI (2)

Francois Chenevier (2)
ANDRA
Route de Panorama Robert Schumann
B. P. 38
92266 Fontenay-aux-Roses, Cedex
FRANCE

Claude Sombret
Centre d'Etudes Nucleaires
de la Vallee Rhone
CEN/VALRHO
S.D.H.A. B.P. 171
30205 Bagnols-Sur-Ceze, FRANCE

Commissariat a L'Energie Atomique
Attn: D. Alexandre
Centre d'Etudes de Cadarache
13108 Saint Paul Lez Durance Cedex
FRANCE

Bundesanstalt für Geowissenschaften und
Rohstoffe (2)
Attn: M. Langer
M. Wallner
Postfach 510 153
D-30631 Hannover, GERMANY

Bundesministerium für Forschung und
Technologie
Postfach 200 706
5300 Bonn 2, GERMANY

Forschungszentrum Karlsruhe GmbH
Institut für Nukleare Entsorgungstechnik
Attn: E. Korthaus
Postfach 3640, D-76021 Karlsruhe
Bundesrepublik Deutschland
GERMANY

Gesellschaft für Anlagen und Reaktorsicherheit
(GRS)
Attn: B. Baltes
Schwertnergasse 1
D-50667 Cologne, GERMANY

Grundbau Und Felsbau GmbH
Attn: W. Wittke
Henricistraße 50
52072 Aachen, GERMANY

Institut Für Gebirgsmechanik
Attn: W. Minkley
Friederikenstraße 60
04279 Leipzig, GERMANY

Institut Für Tieflagerung
Attn: K. Kuhn
Theodor-Heuss-Strasse 4
D-3300 Braunschweig, GERMANY
Shingo Tashiro
Japan Atomic Energy Research Institute
Tokai-Mura, Ibaraki-Ken, 319-11
JAPAN

Netherlands Energy Research Foundation ECN
Attn: J. Prij
3 Westerduinweg
P.O. Box 1
1755 ZG Petten
THE NETHERLANDS

Universiteit Utrecht
Department of Geology (HPT-lab)
Attn: C. J. Spiers
PO Box 80021
NL-3508 TA Utrecht
Budapestlaan 4
THE NETHERLANDS

Svensk Karnbransleforsorjning AB
Attn: F. Karlsson
Project KBS (Karnbranslesakerhet)
Box 5864
S-102 48 Stockholm
SWEDEN

Nationale Genossenschaft für die Lagerung
Radioaktiver Abfälle (2)
Attn: S. Vomvoris
P. Zuidema
Hardstrasse 73
CH-5430 Wettingen
SWITZERLAND

AEA Technology
Attn: J. H. Rees
DSW/29 Culham Laboratory
Abington, Oxfordshire OX14 3DB
UNITED KINGDOM

AEA Technology
Attn: W. R. Rodwell
044/A31 Winfrith Technical Centre
Dorchester, Dorset DT2 8DH
UNITED KINGDOM

AEA Technology
Attn: J. E. Tinson
B4244 Harwell Laboratory
Didcot, Oxfordshire OX11 0RA
UNITED KINGDOM